



10641 Highway 36
Covington, GA
30014

www.sunbeltbuilders.com

t 770.786.3031
f 770.786.3046

NEWTON COUNTY FLEET & PUBLIC WORKS

Matt Davis Plumbing Company
P.O. Box 230
Covington, GA 30015
ph: 678-300-1353
Matt Davis
davisplumbingco@yahoo.com

22-0000 Fleet Plumbing As-built

PLUMBING NOTES

- [illegible]

QTY	SPECIFICATION	DESCRIPTION
(WC)	1 A.D. WATER CLOSET / 1.25 GPM W/ LEFT-HAND TRIP JAWB	KOHLER K-3999 WATER CLOSET, BROWN 16355557 SEAT (CR COAL)S
(WC)	1 A.D. WATER CLOSET / 1.25 GPM W/ RIGHT-HAND TRIP JAWB	KOHLER K-3999 A.D. WATER CLOSET, BROWN 16355557 SEAT (CR COAL)S
(WC)	3 WATER CLOSET / 1.25 GPM	KOHLER K-3999 WATER CLOSET, BROWN 16355557 SEAT (CR COAL)S
(BATH)	2 URINAL, WALL HUNG, A.D.A.	KOHLER MANHUA, TUBURY PAINT, 150 IN.6 SUCANI 106 (CR COAL)S
(WC)	4 A.D.A. DROP-IN LAVATORY 0.5 GPM	KOHLER K-2 19C / LAVATORY, DELTA 50 / 1.5-GPM FAUCET (CR COAL)S
(BATH)	1 A.D.A. WALL HUNG LAVATORY 0.5 GPM	KOHLER K-2005 LAVATORY, DELTA 50 / 1.5-GPM FAUCET (CR COAL)S
(SINK)	1 A.D.A. BREAK ROOM SINK 1.5 GPM	ELAVY T9262322 SINK, DELTA 9 / 1.5-GPM FAUCET
(KITCHEN)	1 24" 24" TERRAZZO TOP SINK	FAT T92623 SINK, A.S.M.A. FAUCET, A.S.M.A. ROSEBACCH, 6593C2 MPT HANGER, M526244 PANELS, 002332 PRAIN AND 145598 STRAINER (CR COAL)S
(SINK)	1 CE. MAJOR BOV WITH WATER HAMMER ARRESTOR	WATER TITE AB970 PHS (CR COAL)S
(SINK)	1 49W X 34D X 77H SHOWERS UNIT	STRILING 773 2 X 1050, DELTA 1 / 1.4329 FAUCET (CR COAL)S
(WC)	1 WATER WATER	BRANDFORD WHITE, 50 GALLON ELECTRIC 240 / 120 VOLT
(SINK)	1 FLOOR DRAIN	SICOM CHEF CR COAL

A New Office Renovation Plan For
Newton County
(Fleet Maintenance Bldg)

A New Office Renovation Plan For

65 Piper Road

65 Piper Road

1	10-31-2025
	Permit Plans

Project No.

00-00

ad File Name

rawing Scale

 $\cdot 3/16'' = 1'-0''$

- Drain, Waste and

Vent Plan - Level

rawn Checked

• dcm • gl

Sunbelt Builders, Inc. ©

DRAWINGS AND SPECIFICATIONS ARE

STRUMENTS OF SERVICE AND SHALL REMAIN THE PROPERTY OF THIS CORPORATION UNTIL THE

PROJECT FOR WHICH THEY ARE MA-
EXECUTED OR NOT. THEY ARE N

NOT BE USED ON OTHER PROJECTS
OR EXTENSIONS TO THIS PROJECT
EXCEPT BY AGREEMENT IN WRITING

AND APPROPRIATE COMPENSATION
TO THIS CORPORATION.


DRAWING NUMBER

III.0.1 = C

→
C
→

4	
5	
4	

ALPHA BLDG SET 02-23-2026

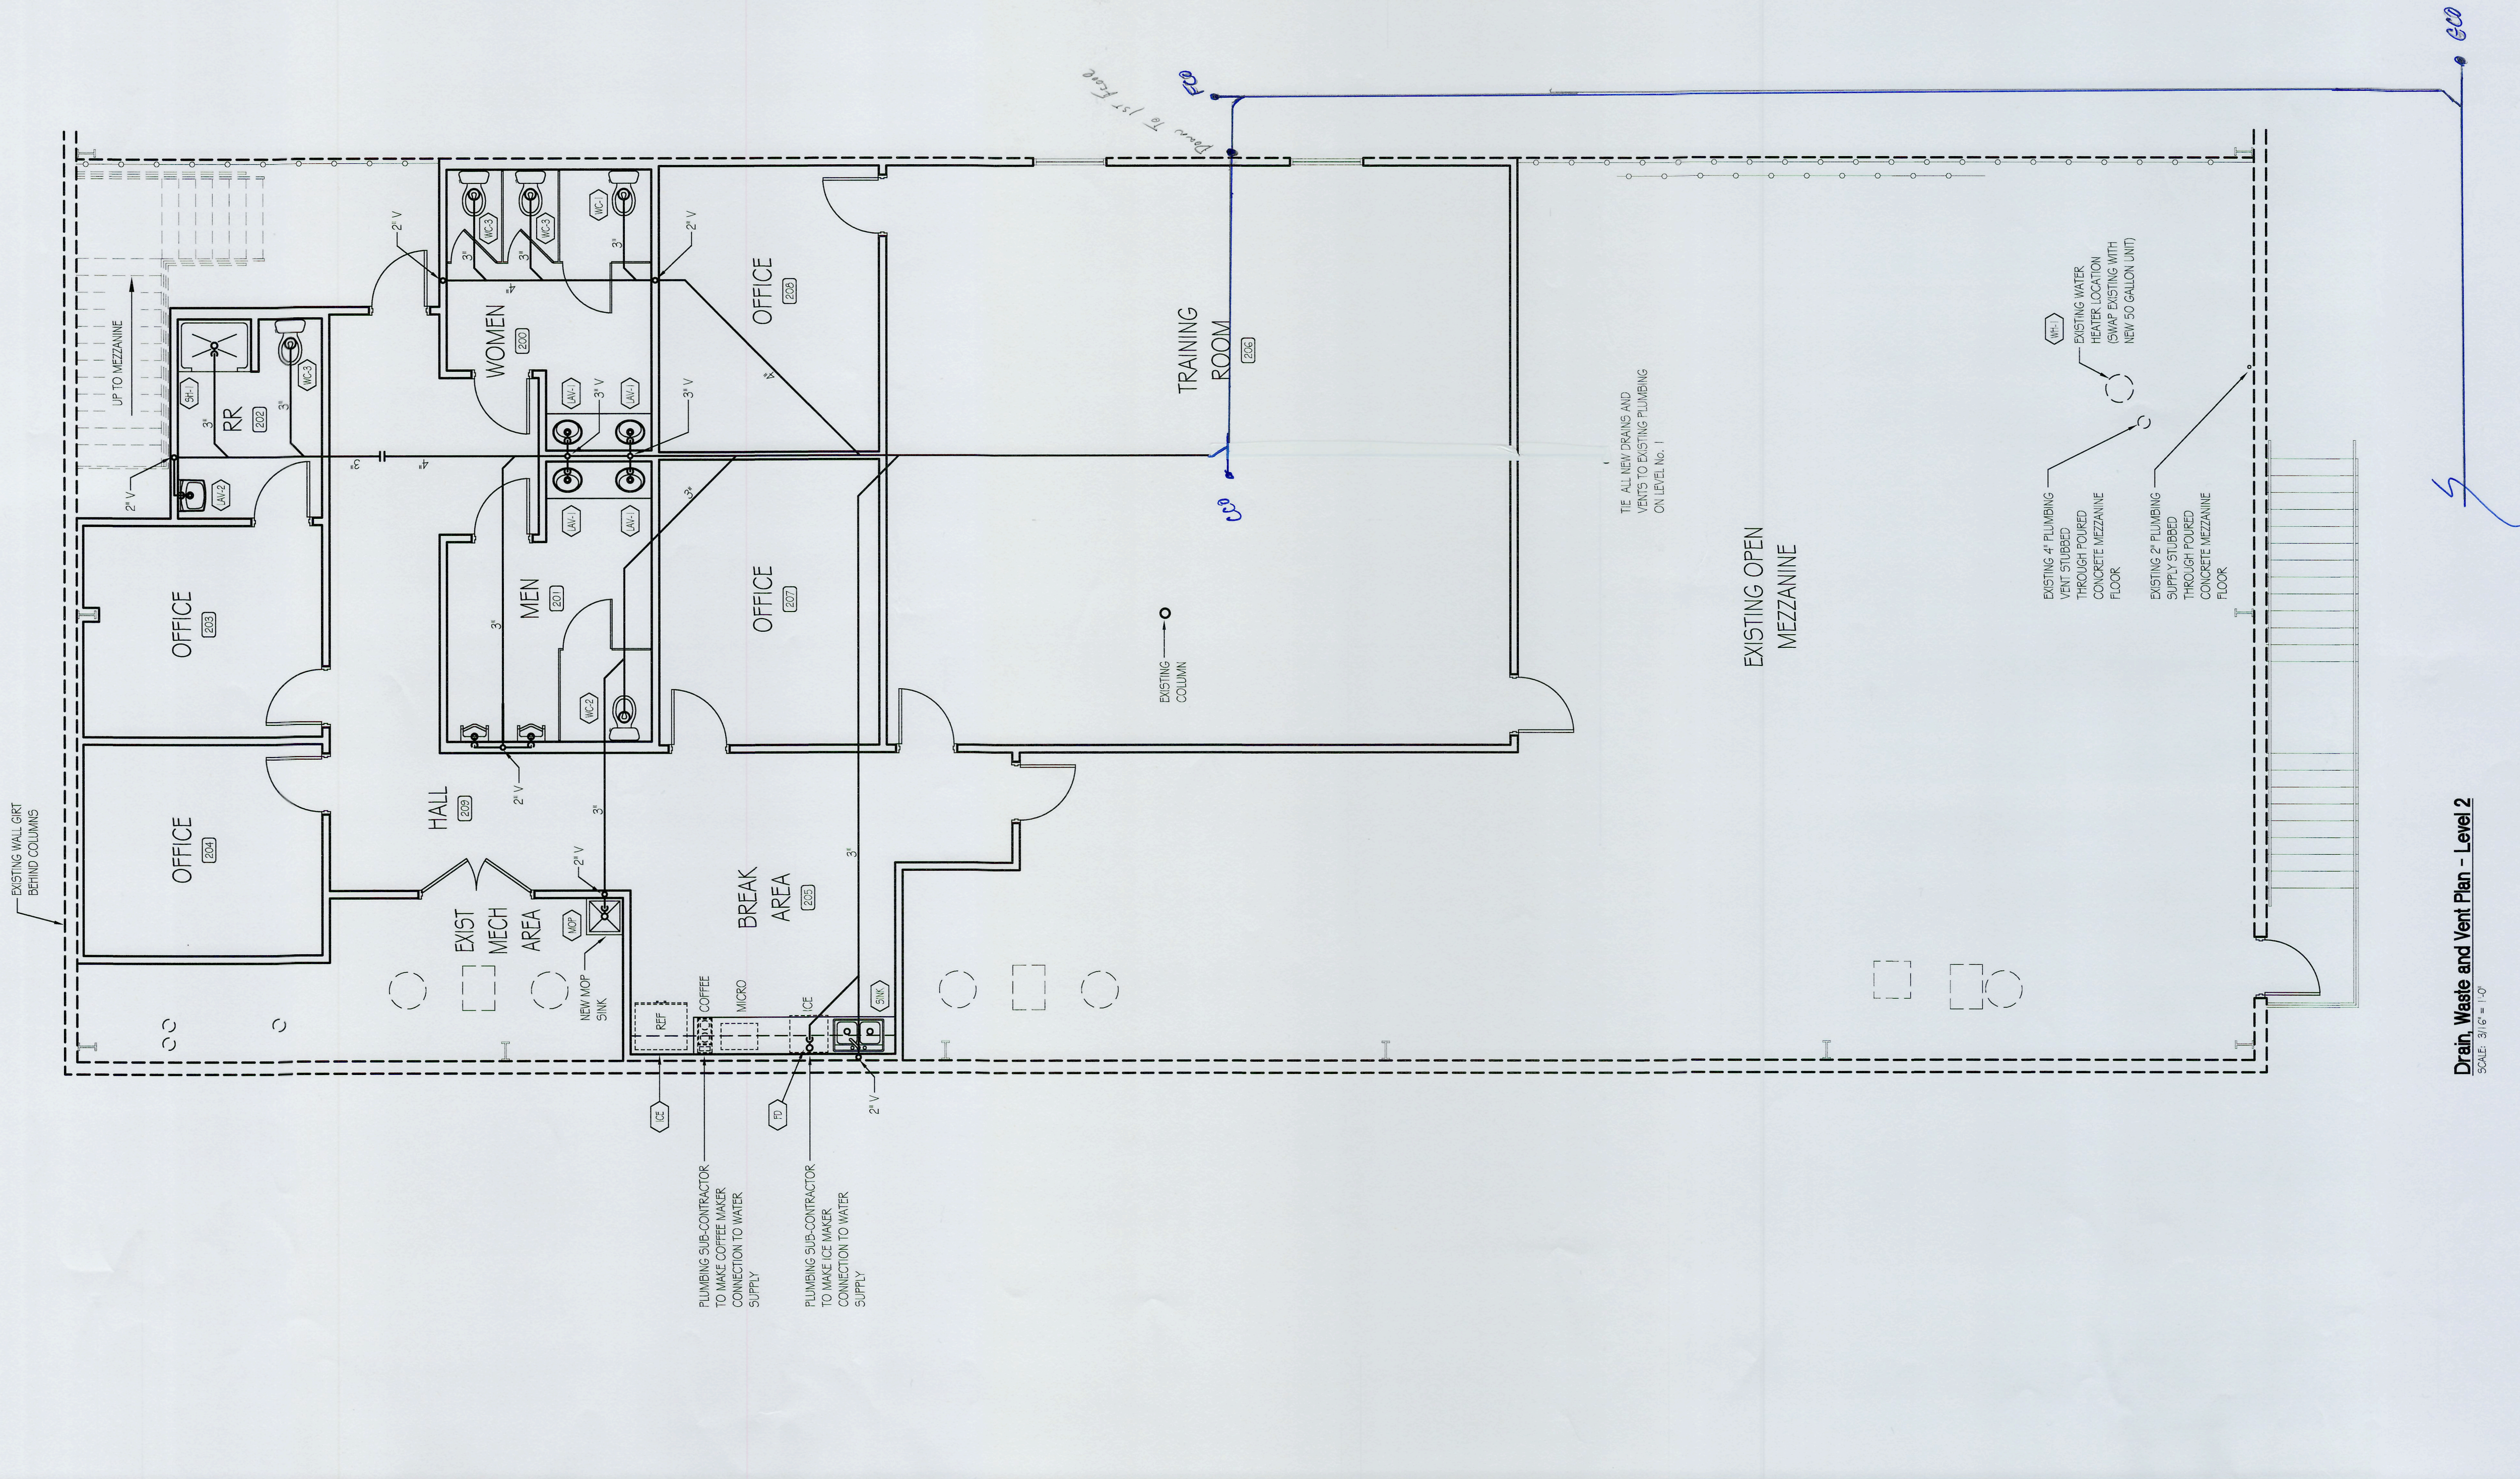

Drain, Waste and Vent Plan - Level 2

$$A_1 = 91\% = 31\%$$