



10641 Highway 36
Covington, GA
30014

www.sunbeltbuilders.com

t 770.786.3031
f 770.786.3046


NEWTON COUNTY FLEET & PUBLIC WORKS

Matt Davis Plumbing Company
P.O. Box 230
Covington, GA 30015
ph: 678-300-1353
Matt Davis
davisplumbingco@yahoo.com

22-0000 Public Works Plumbing As-built

PLUMBING NOTES

- [illegible]

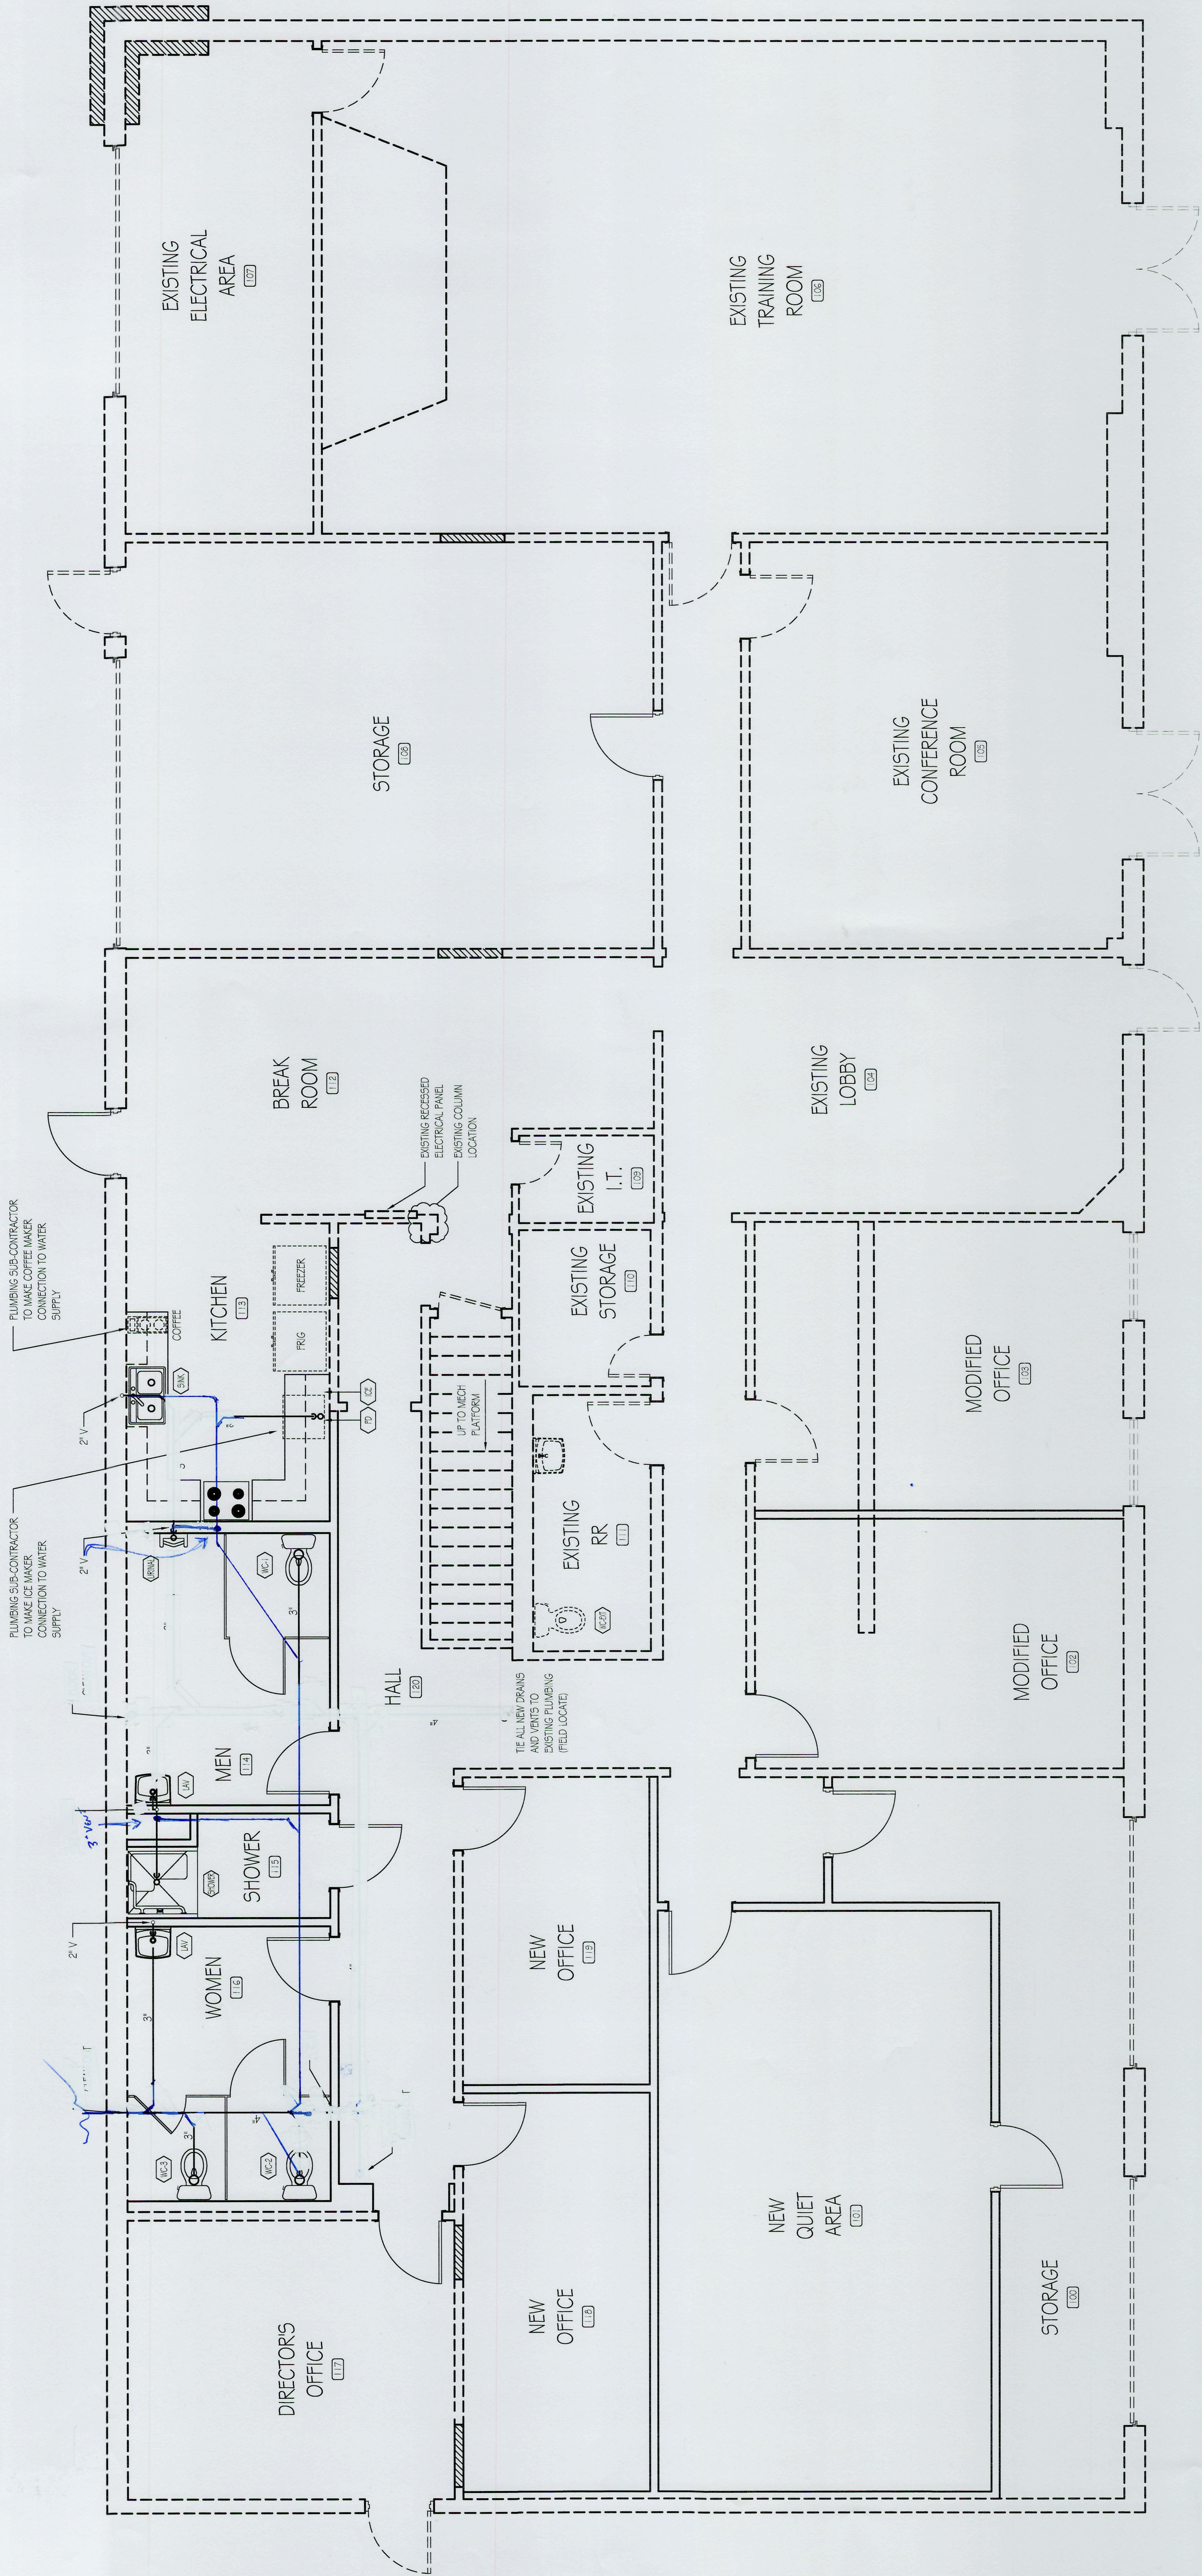

Drain, Waste and Vent Plan
SCALE: 1/4" = 1'-0"

PLUMBING FIXTURE SCHEDULE

KEY	QTY.	DESCRIPTION	REMARKS
(62)	1	A.C.U. WATER CLOSET - 28 OFF	KOHLER K-3999 WATER CLOSET, BOWLS (63550) SEAT (OR EQUAL)
(62)	1	A.O.A. WATER CLOSET - 28 OFF W/ ROOF-HAND FOR ENTRY	KOHLER K-3999-A.R. WATER CLOSET, BOWLS (63550) SEAT (OR EQUAL)
(62)	2	WATER CLOSET - 28 OFF	KOHLER K-3999 WATER CLOSET, BOWLS (63550) SEAT (OR EQUAL)
(62B)	1	PILING	PLUMBING SUBCONTRACTOR TO REINSTALL EXISTING PICTURE (OR EQUAL)
(62B)	1	URINAL WALL HUNG, A.O.A.	KOHLER MANIA URUSH VALVE, CSO 1/6, SUCANI 1/6 (OR EQUAL)
(16)	2	A.C.U. WALL HUNG LAVATORY 0.5 GPM	KOHLER K-2005 LAVATORY, DETA 30" WF PALCET (OR EQUAL)
(30B)	1	A.O.A. BREAK ROOM SINK - 1.5 GPM	ELECTRICAL 220V 30A SINK, DETA 9" 1.5-GP PALCET (OR EQUAL)
(12)	1	C.E. HANGER BOX WITH WATER HAMMER ARRESTOR	WATER TITE M8701 HA (OR EQUAL)
(9)	1	FLOOR DRAIN	SIXCO CHIEF OR EQUAL
(60B)	1	A.C.U. COMPLAINT SHOWER	KOHLER A.O.A. SHOWER STALL, 36"x 36" SHOWER HEAD, 1.5 GPM MAX. TUBING SHAW AND INTEGRAL SOAP LATCH PALCET TO BE SINGLE HANDLE ONCEY OFF TEMPERATURE ADJUSTMENT. HEAD TO BE ADJUSTABLE HEIGHT. REMOVABLE HAND HELD TUBE WITH ADOUBLE ACTION SPRAY

1	10-31-2025	Permit Plans			

Project No.
• 00-00
Cad File Name
• 00-00_NC_09_p10
Drawing Scale
• 1/4" = 1'-0"

Drawn	Checked
.dem	.gl

Sunbelt Builders, Inc. (S)

DRAWINGS AND SPECIFICATIONS ARE INSTRUMENTS OF SERVICE AND SHALL REMAIN THE PROPERTY OF THIS CORPORATION WHETHER THE PROJECT FOR WHICH THEY ARE MADE IS EXECUTED OR NOT. THEY ARE NOT TO BE USED ON OTHER PROJECTS OR EXTENSIONS TO THIS PROJECT EXCEPT BY AGREEMENT IN WRITING AND APPROPRIATE COMPENSATION TO THIS CORPORATION.

**A New Office Renovation Plan For
Newton County
(Public Works Bldg)**
65 Piper Road
Covington, Georgia

tion County
Works Bldg
65 Piper Road
Covington, Georgia

Architect or Engineer Seal

8 9 1 0 11 12 13 100

10641 HWY 86, COWINGTON, GA 30014 t 770 788.9031 f 770 788.9086
S U N I D E R STM