



10641 Highway 36
Covington, GA
30014

www.sunbeltbuilders.com

t 770.786.3031
f 770.786.3046

NEWTON COUNTY FLEET & PUBLIC WORKS

Sunbelt Builders, Inc.

10641 Hwy. 36





Covington, GA 30014

ph: 770-786-3031

Ryan Lewis

rlewis@sunbeltbuilders.com

Architectural As-built – Fleet

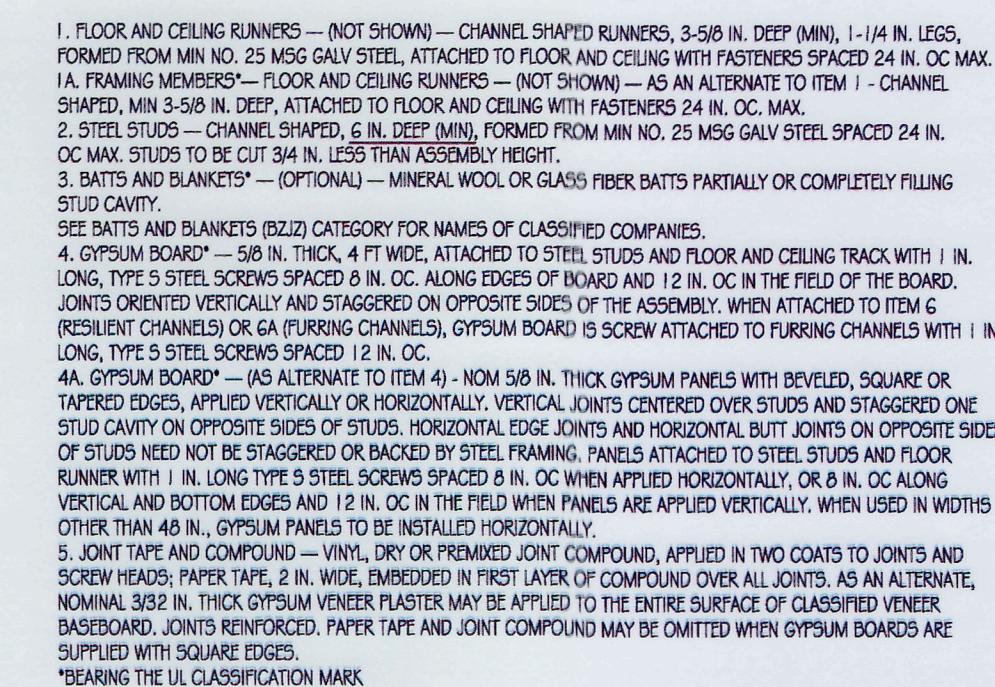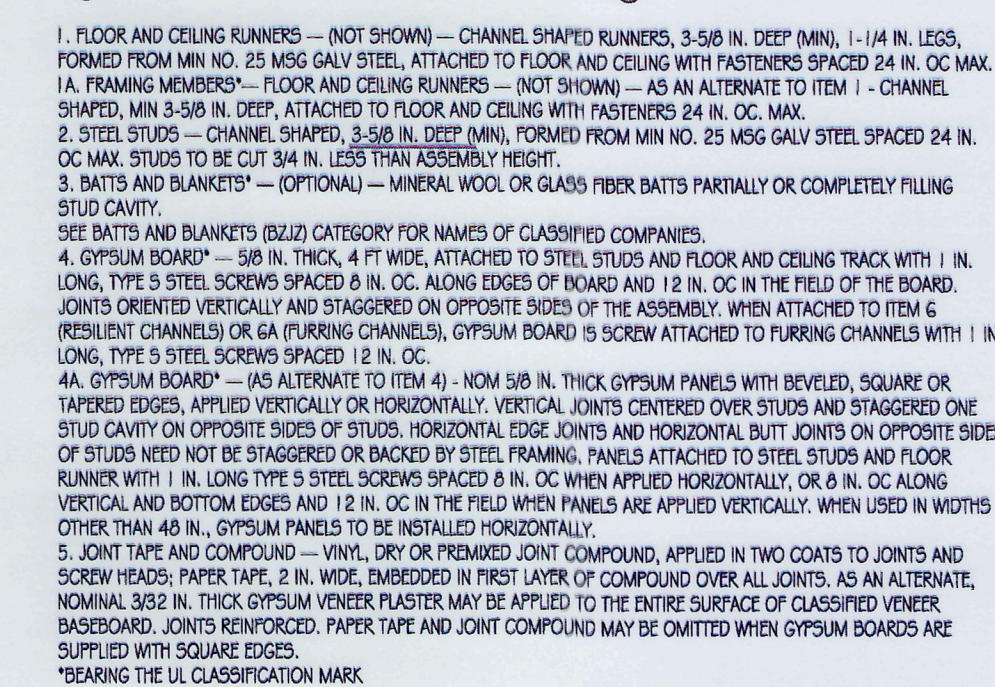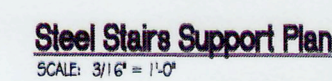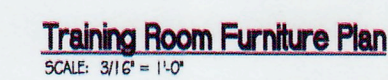

1. WALLS AND PARTITIONS WITHIN 2'-0" OF ANY SERVICE SINK, URINAL, OR WATER CLOSET SHALL HAVE A SMOOTH, HARD, NONABSORBENT SURFACE, TO A HEIGHT OF NOT LESS THAN 4'-0" ABOVE THE FLOOR, AND EXCEPT FOR STRUCTURAL ELEMENTS, THE MATERIALS USED IN SUCH WALLS SHALL BE OF A TYPE THAT IS NOT ADVERSELY AFFECTED BY MOISTURE.

ICC DOES NOT RECOGNIZE PAINT OR WALL COVERING AS A "HARD, NON-ABSORBENT SURFACE"