



10641 Highway 36
Covington, GA
30014

www.sunbeltbuilders.com


t 770.786.3031
f 770.786.3046

Newton County – R.L. Cousins Center

Moseley Electric
7187-D Washington Street
Covington, GA 30014
ph: 770-786-2678
Keith Battaglia
keithbattaglia1@yahoo.com

26-0000 Electrical As-built

ALPHA BLDG SET 08-27-2024

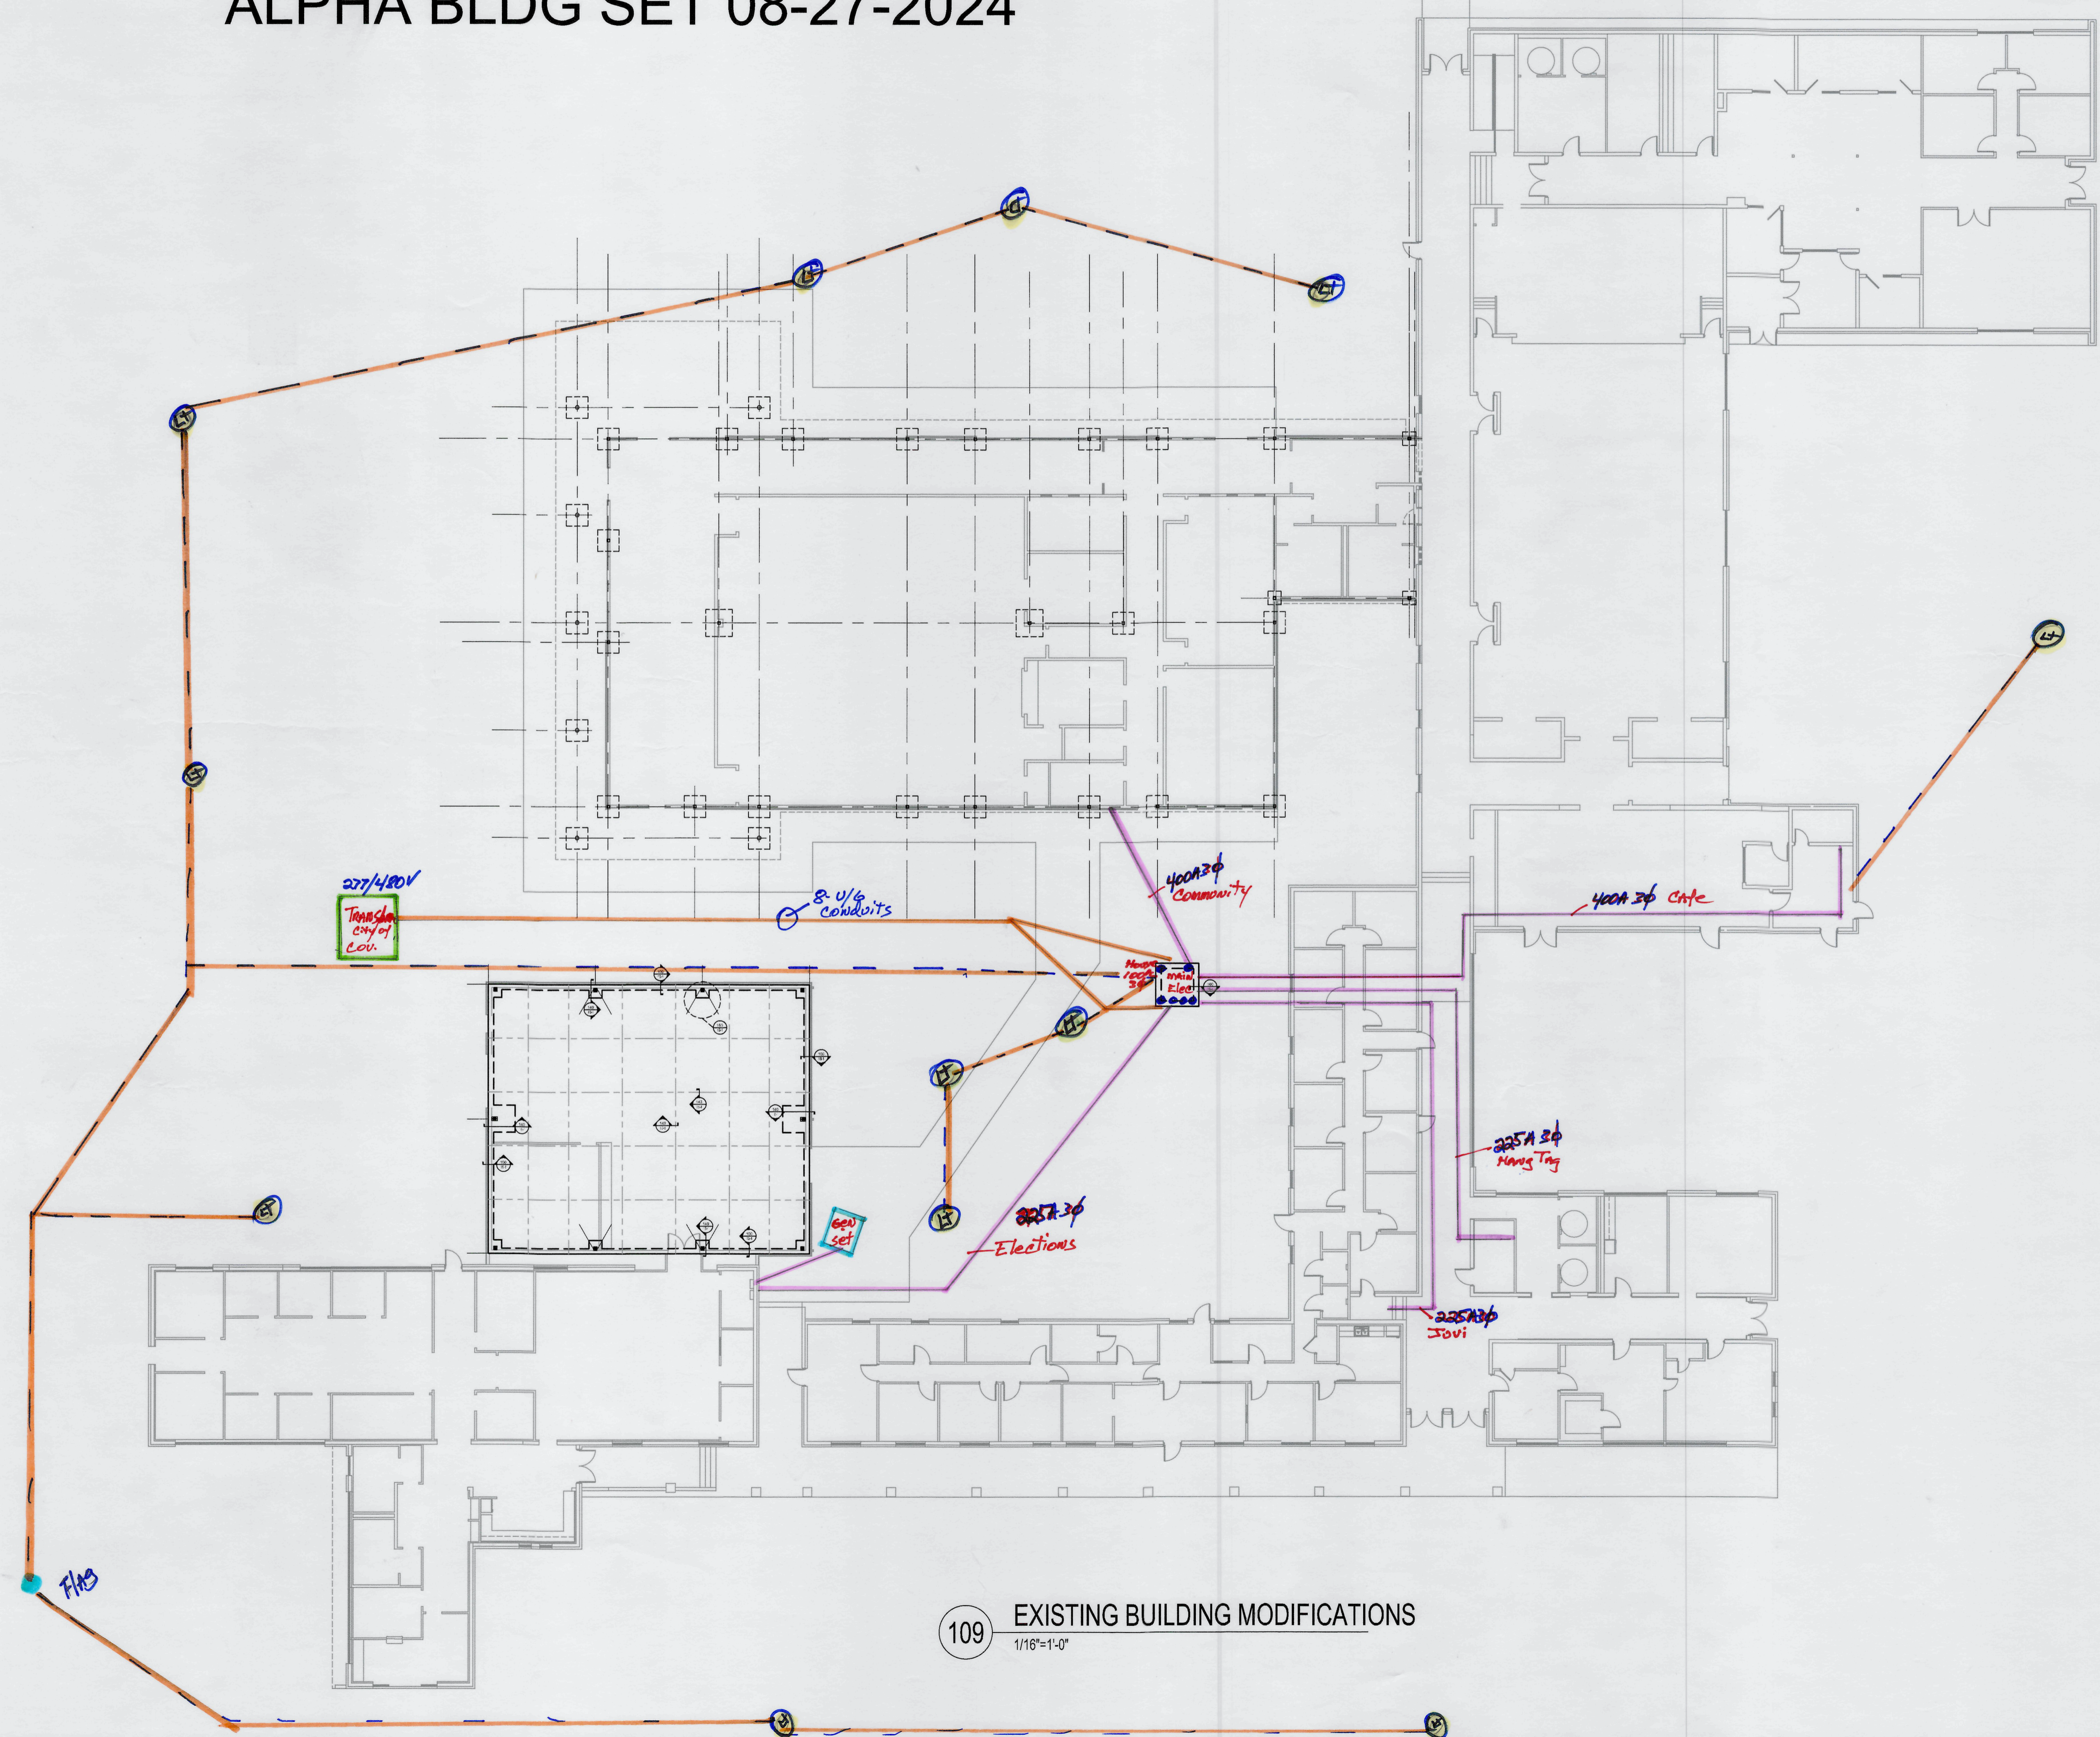

109 EXISTING BUILDING MODIFICATIONS
1/16"=1'-0"

P:\Projects\2024\Alpha Bldg Set\Alpha Bldg Set.dwg (1/16"=1'-0")
 PLOTTED BY: J. B. BROWN, DATE: 08/27/2024, TIME: 10:00 AM
 PLOT SCALE: 1/16"=1'-0"

OCONEE ENGINEERING L.L.C.
 STRUCTURAL ENGINEERING
 ATHERS, GA.
 LAKE OCONEE, GA.
 P.O. Box 116
 2610 Bowman Pkwy Road
 Grandboro, GA 30924
 P: (770) 313-0302
 email: oconeeengineeringllc@gmail.com



As Built
R.L. COUSINS COMMUNITY CENTER
 NEWTON CO. BOC RFP #24-04
 8134 GEIGER STREET, COVINGTON, GA
 FOR: SUNBELT BUILDERS

MARK	DATE	BY	DESCRIPTION
5-5-2024	4-22-2024		ISSUE FOR BIDDING
			ISSUE FOR BIDDING

OE PROJECT NO: OE24007
 FILE NAME: OE24007-S-CORE
 ORIGINAL DRAWING SIZE: 36"x24"
 DATE: 4-22-2024
 © COPYRIGHT 2024. UNAUTHORIZED USE OF ANY KIND, INCLUDING USE ON OTHER PROJECTS, IS PROHIBITED. ANY ALTERATIONS OR REPRODUCTIONS MUST BE AUTHORIZED IN WRITING BY OCONEE ENGINEERING, L.L.C.

PHASE ONE
 EXISTING BLDG.
 MODIFICATIONS