



10641 Highway 36
Covington, GA
30014



www.sunbeltbuilders.com

t 770.786.3031
f 770.786.3046

FACTORY SHOALS PARK

AC Electric
1090 Pleasant Valley Road
Monroe, GA 30655
ph: 404-787-4662
Adam Brown
adam@acelectricalga.com

26-0000 Electrical Northside As-built

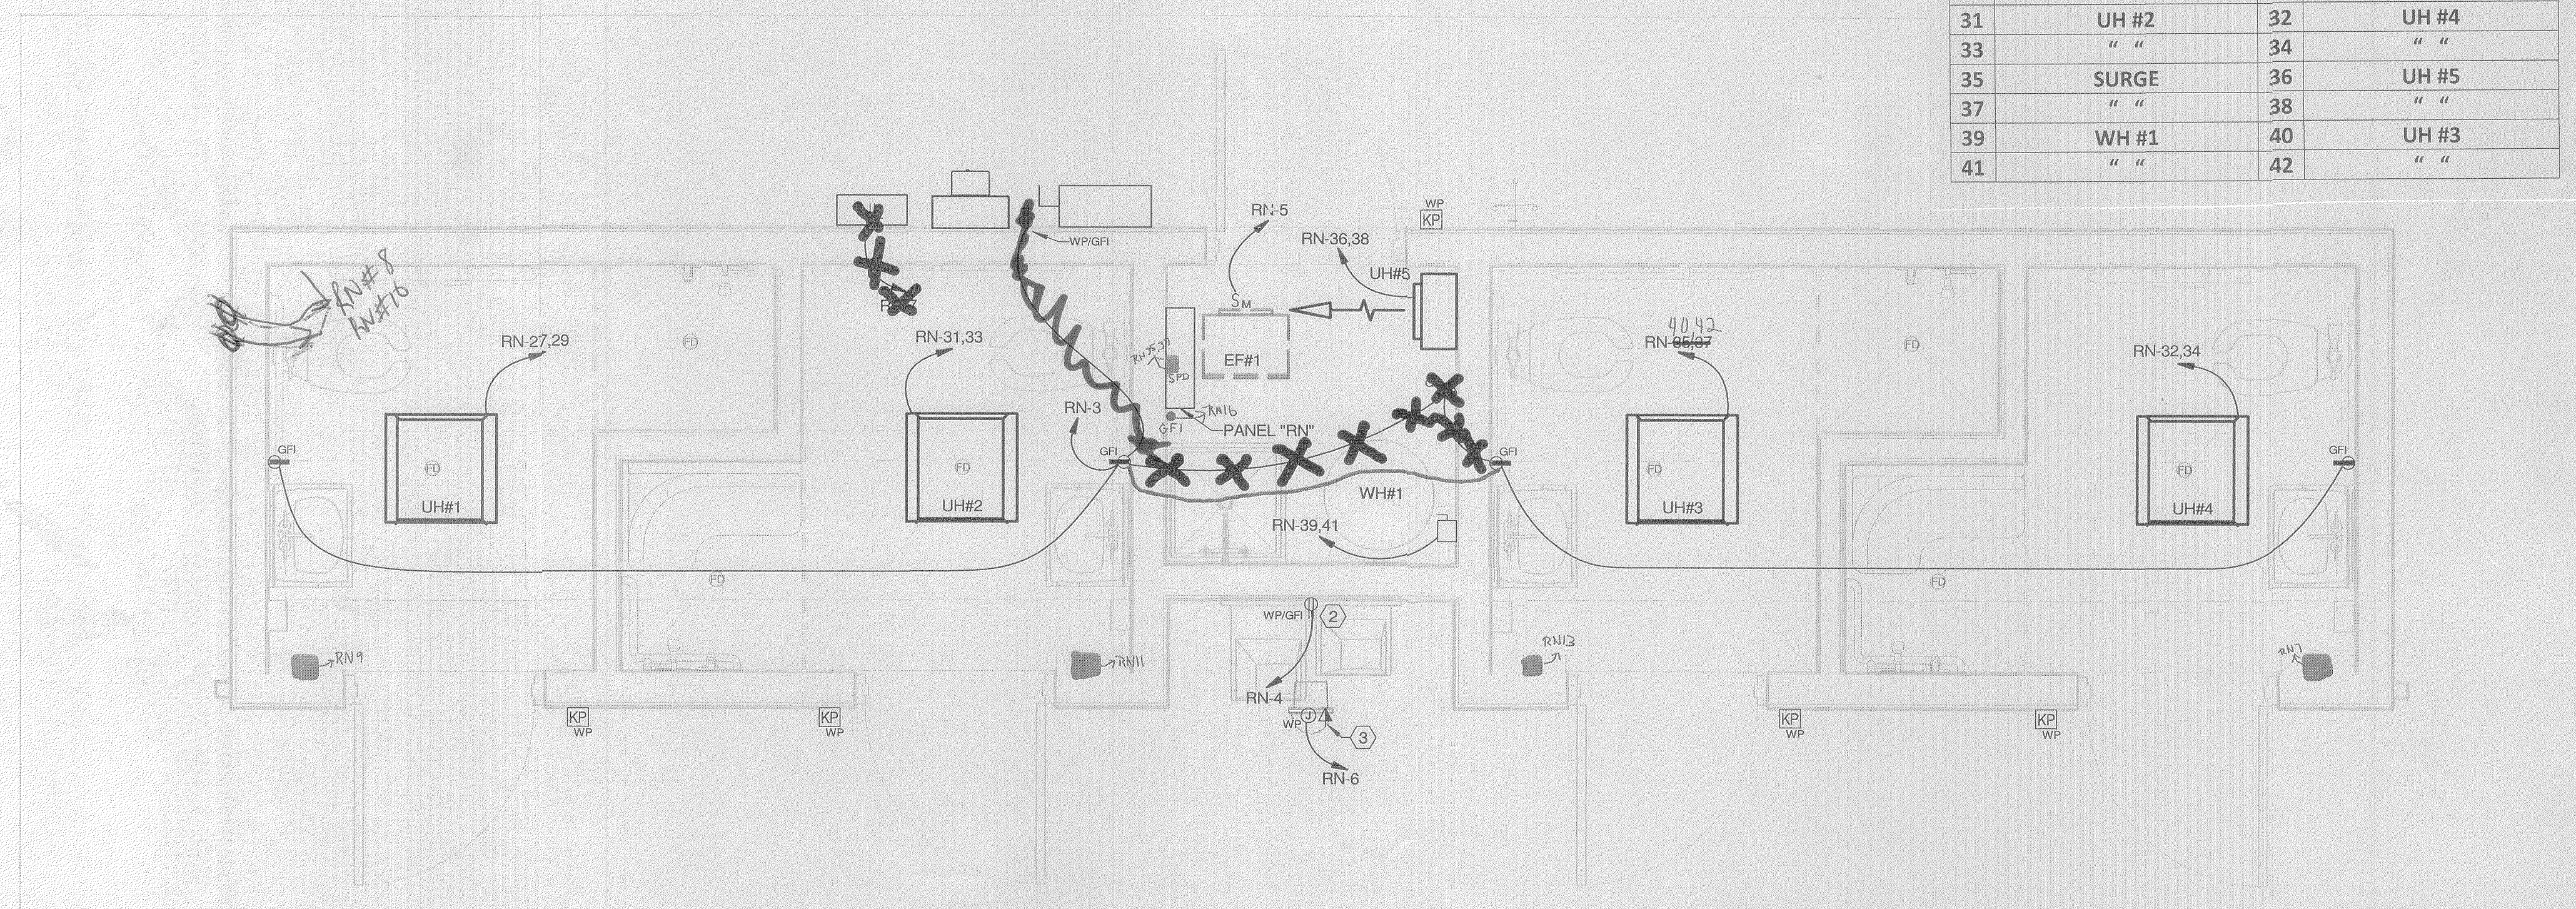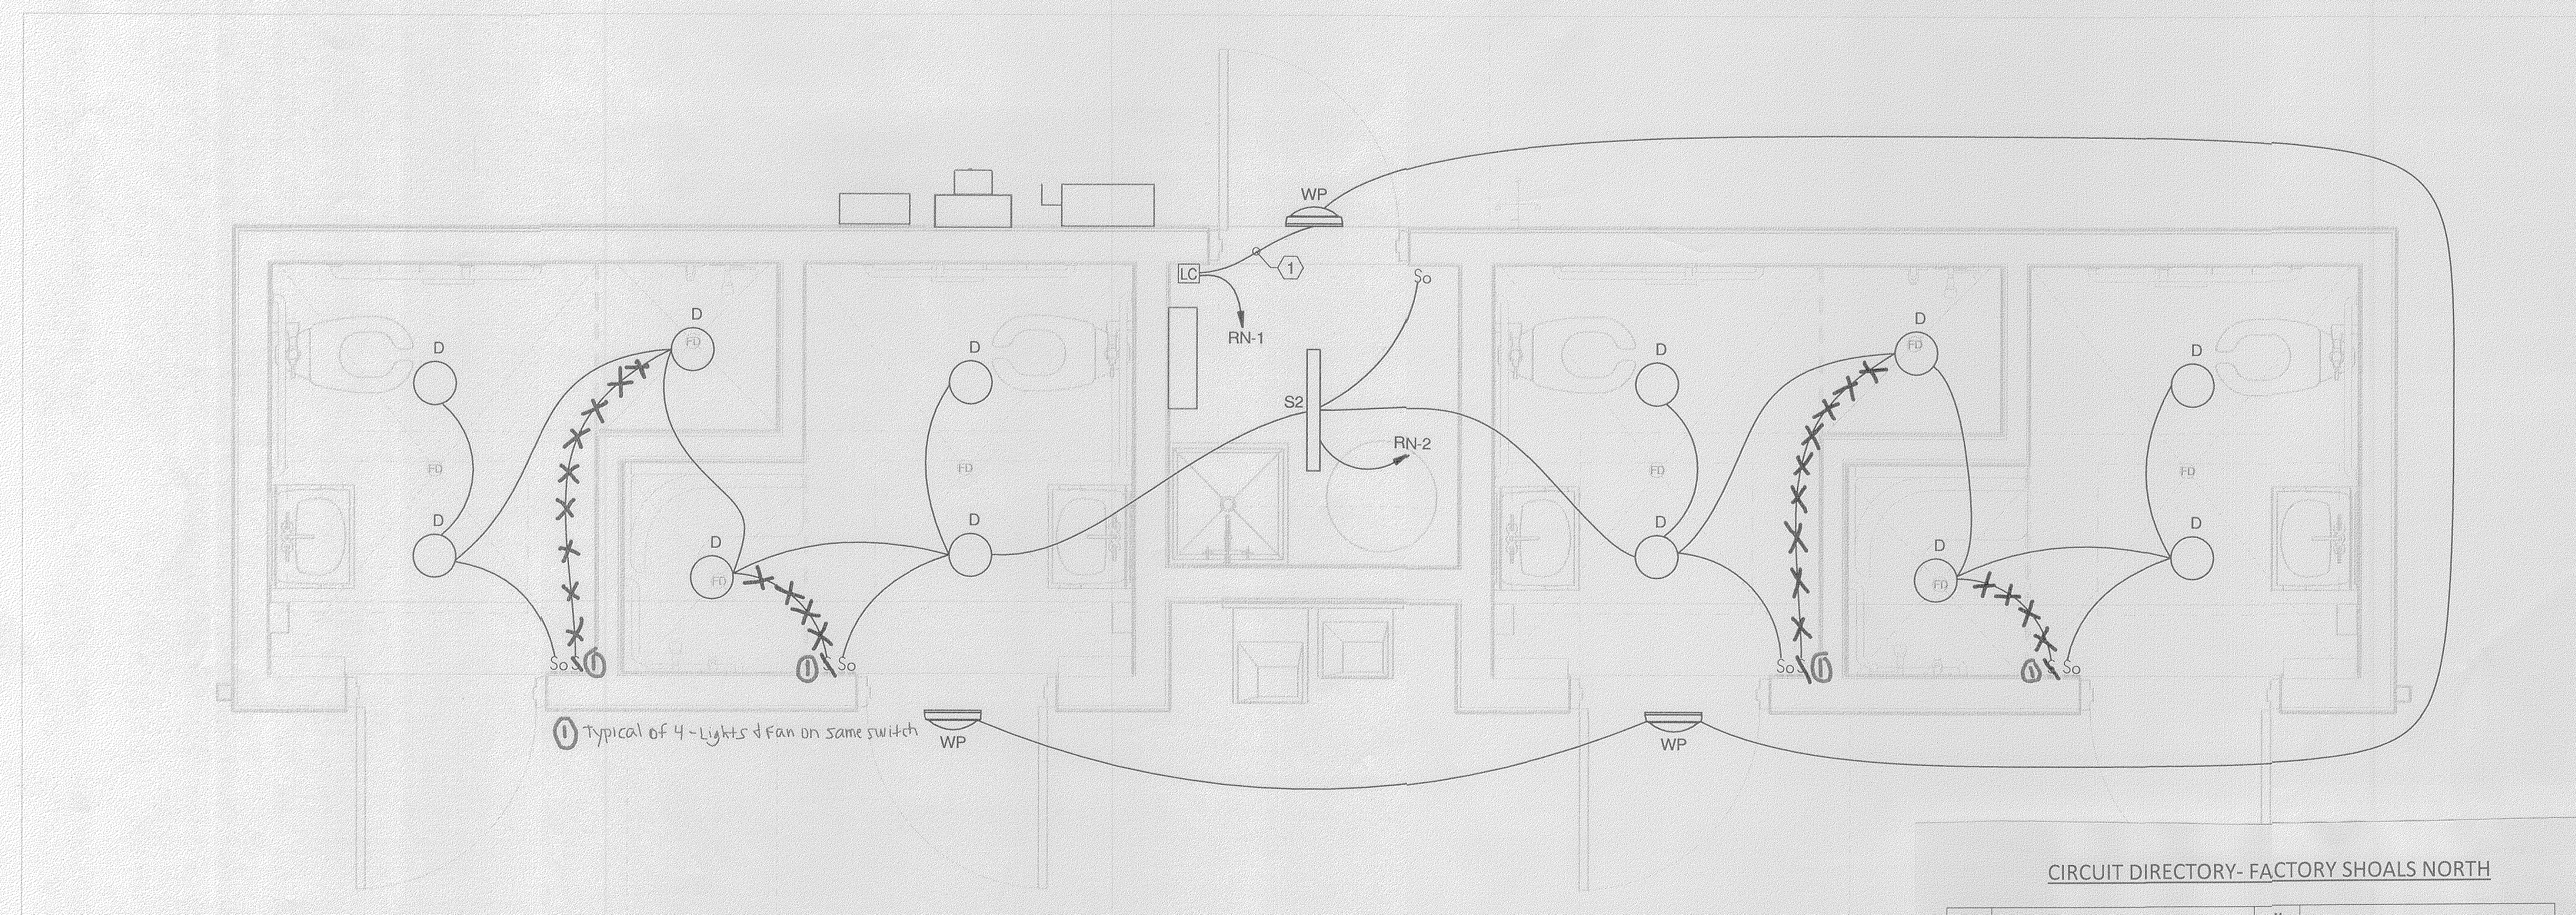

1. ROUTE LIGHTING CIRCUIT THROUGH LIGHTING CONTACTOR "LC-N".
2. PROVIDE POWER FOR ELECTRIC FAUCET. COORDINATE EXACT LOCATION AND ALL REQUIREMENTS WITH OWNER PRIOR TO ROUGH-IN.
3. PROVIDE POWER AND DATA FOR CAMERA. COORDINATE EXACT LOCATION AND ALL REQUIREMENTS WITH SECURITY VENDOR PRIOR TO ROUGH-IN.

CIRCUIT DIRECTORY- FACTORY SHOALS NORTH			
#		#	
1	LIGHTING- EXTERIOR	2	LIGHTING- INTERIOR
3	REC: BUILDING	4	REC: FOUNTAIN
5	EF #1	6	CAMERA
7	HAND DRYER #4	8	SEPTIC PUMP
9	HAND DRYER #1	10	PUMP
11	HAND DRYER #2	12	SPARE
13	HAND DRYER #3	14	SPARE
15	SPARE	16	REC: PANEL
17	SPACE	18	SPACE
	SPACE	20	SPACE
21	SPACE	22	SPACE
23	SPACE	24	SPACE
25	SPACE	26	SPACE
27	UH #1	28	SPACE
29	" "	30	SPACE
31	UH #2	32	UH #4
33	" "	34	" "
35	SURGE	36	UH #5
	" "	38	" "
39	WH #1	40	UH #3
41	" "	42	" "

MECHANICAL EQUIPMENT SCHEDULE (NORTH RESTROOMS)						
UNIT #	UNIT DESCRIPTION	VOLTAGE (V)	PHASE	MCA (A)	MOPC (A)	DISCONNECT
EF#1	EX-HAUST FAN (1)	120	1	1.0	20	MOTOR SWITCH
UH#1	UNIT HEATER (2)	240	1	20.8	30	INTEGRAL DISCONNECT
UH#2	UNIT HEATER (2)	240	1	20.8	30	INTEGRAL DISCONNECT
UH#3	UNIT HEATER (2)	240	1	20.8	30	INTEGRAL DISCONNECT
UH#4	UNIT HEATER (2)	240	1	20.8	30	INTEGRAL DISCONNECT
UH#5	UNIT HEATER (2)	240	1	20.8	30	INTEGRAL DISCONNECT



PLUMBING EQUIPMENT SCHEDULE (NORTH RESTROOMS)						
UNIT #	UNIT DESCRIPTION	VOLTAGE (V)	PHASE	MCA (A)	MOCp (A)	DISCONNECT
WH#1	WATER HEATER	240	1	37.5	50	240/2/60

NOTES:
(1) EXHAUST FAN TO BE CONTROLLED BY OCCUPANCY SENSOR IN ROOM
(2) FLUSH MOUNTED INTEGRAL DISCONNECT SWITCH INCLUDED.

☐ HAND DRYER

☐ SURGE PROTECTOR

LOSE
DESIGN
SPACES FOR LIFE

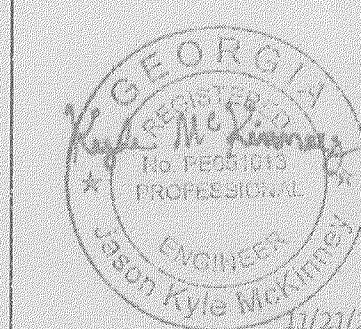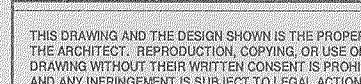

PARSONS
ENGINEERING, INC.
NASHVILLE, TENNESSEE
PARSONSENGINEERING.COM

FACTORY SHOALS PARK NORTHSIDE
RESTROOM BUILDING

PREPARED FOR:
NEWTON COUNTY, GEORGIA

GEORGIA

COVINGTON

SUBMITTALS / REVISIONS		
NO	DATE	DESCRIPTION

[illegible]

SHEET TITLE:

**ELECTRICAL
PLAN - NORTH
RESTROOMS**

PROJECT NO. 23042-1	DATE 11/21/2025
DRAWN BY SEJ	SCALE As indicated
CHECKED BY JKM	
SHEET NO.	

E2.01N