



10641 Highway 36
Covington, GA
30014


www.sunbeltbuilders.com

t 770.786.3031
f 770.786.3046

HISTORIC JAIL RENOVATIONS

FireAway
636 Moore Street
Oxford, GA 30054
ph: 770-918-0527
Paul Green, Jr.
paul@atlantafiresprinklers.com



28-4620 Fire Alarm As-built

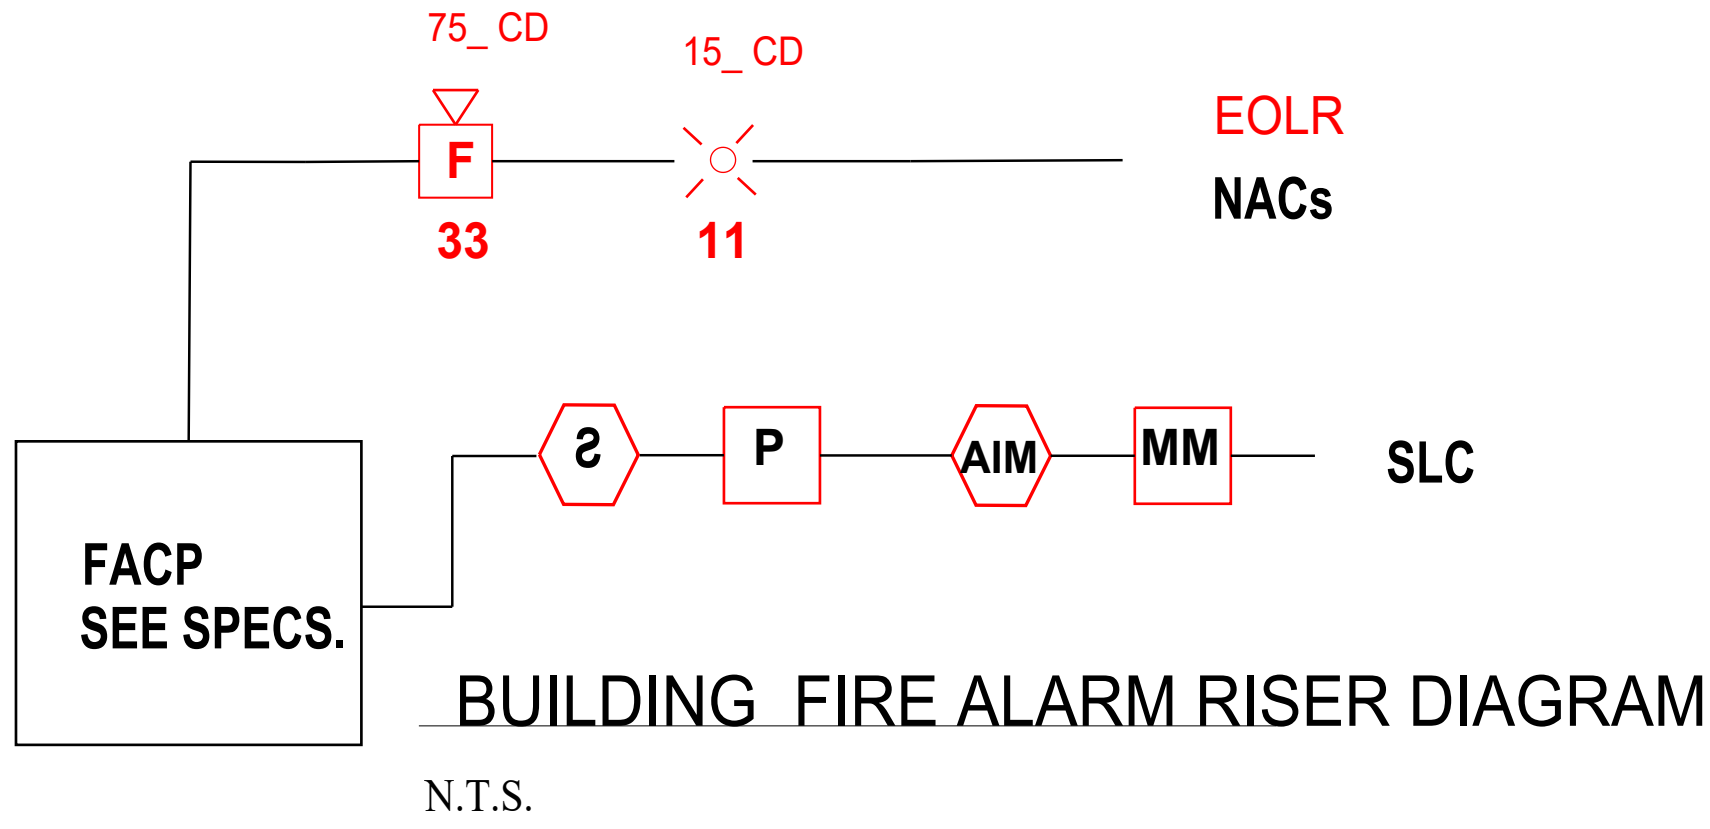

- WIRING NOTES
1. ALL WIRE RUNS SHALL BE CONTINUOUS WITH NO SPLICES BETWEEN DEVICES AND PANEL TERMINATIONS.
 2. ALL DEVICES, PANELS ETC. SHALL BE INSTALLED PLUMB AND LEVEL. ALL CONDUITS SHALL BE PLUMB AND LEVEL.
 3. REFER TO SPECIFICATIONS FOR INSTALLATION AND SCOPE REQUIREMENTS. NO DEVIATIONS TO THE SPECIFICATIONS ARE ALLOWED.
 4. ALL CIRCUITS SHALL BE LABELED AND IDENTIFIED. CHECK CIRCUITS FOR SHORTS, GROUNDSAND OPENS. VERIFY ALL EOL (END OF LINE) RESISTORS ARE READ WITH A VOM FOR PROPER VALUES.

	Actual Common Alarm Signal Indicator	Send Alarm Signal to Central Station	Actual Common Trouble Signal	Send Trouble Signal to Central Station	Actual Device Address Alarm Indicator	Actual Air Conditioner Shutdown (by Owner)
Pull Station-at Doors	X	X		X	X	
Smoke Detectors	X	X		X	X	
Duct Detectors	X	X		X	X	X
Flow Switch	X	X		X	X	
A/C Failure			X	X	X	
Open Circuit			X	X	X	
Ground Fault			X	X	X	
Short Circuit in SLC Circuit			X	X	X	
Short Circuit in NAC Circuit			X	X	X	
Tamper Switch			X	X	X	
Battery Failure			X	X	X	

Quantity		FIRE ALARM SYSTEM DEVICE LEGEND
1	FACP	FIRE ALARM SYSTEM CONTROL PANEL
3	2 P	SMOKE DETECTOR
11	F	FIRE ALARM PULL STATION - 48" Above Fin. Floor
25	75 CD	FIRE ALARM HORN STROBE - WALL
8	75 CD C	FIRE ALARM HORN STROBE - CEILING
1	ANN	REMOTE ANNUNCIATOR
1	AIM	Dual Input Monitor Module - MDF-300 Tamper Switch Flow Switch
4	EOL	End of line Device - Resistor
11		FIRE ALARM Strobe Only Ceiling Mount
2	MM	DUCT DETECTORS BY OTHERS

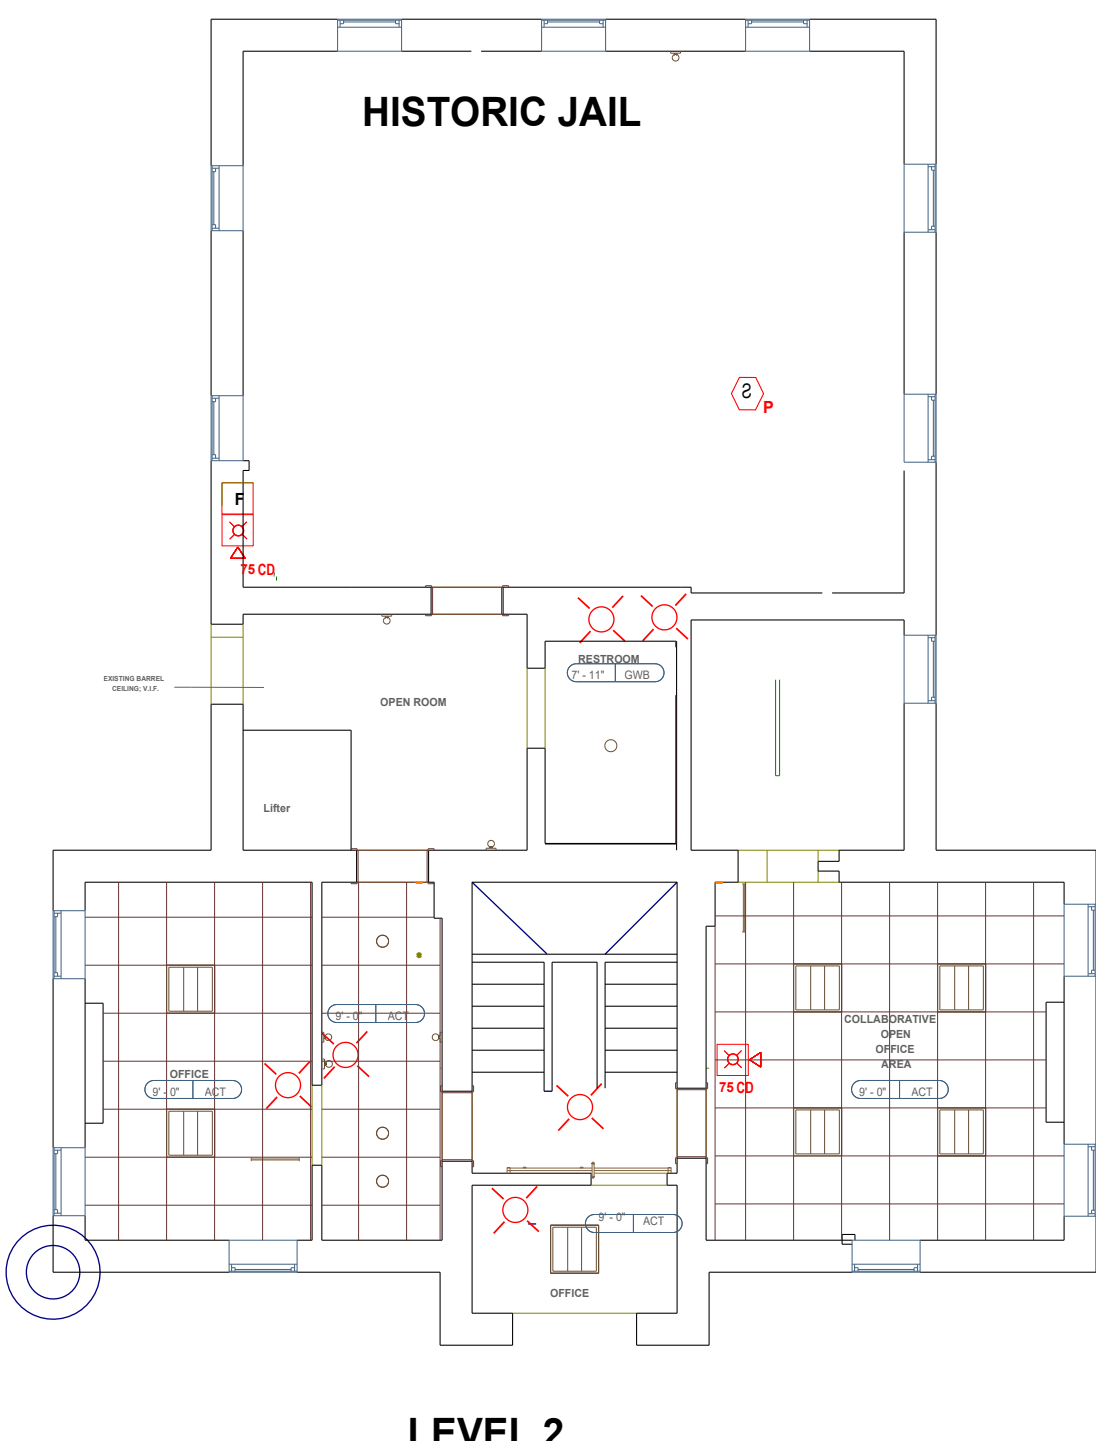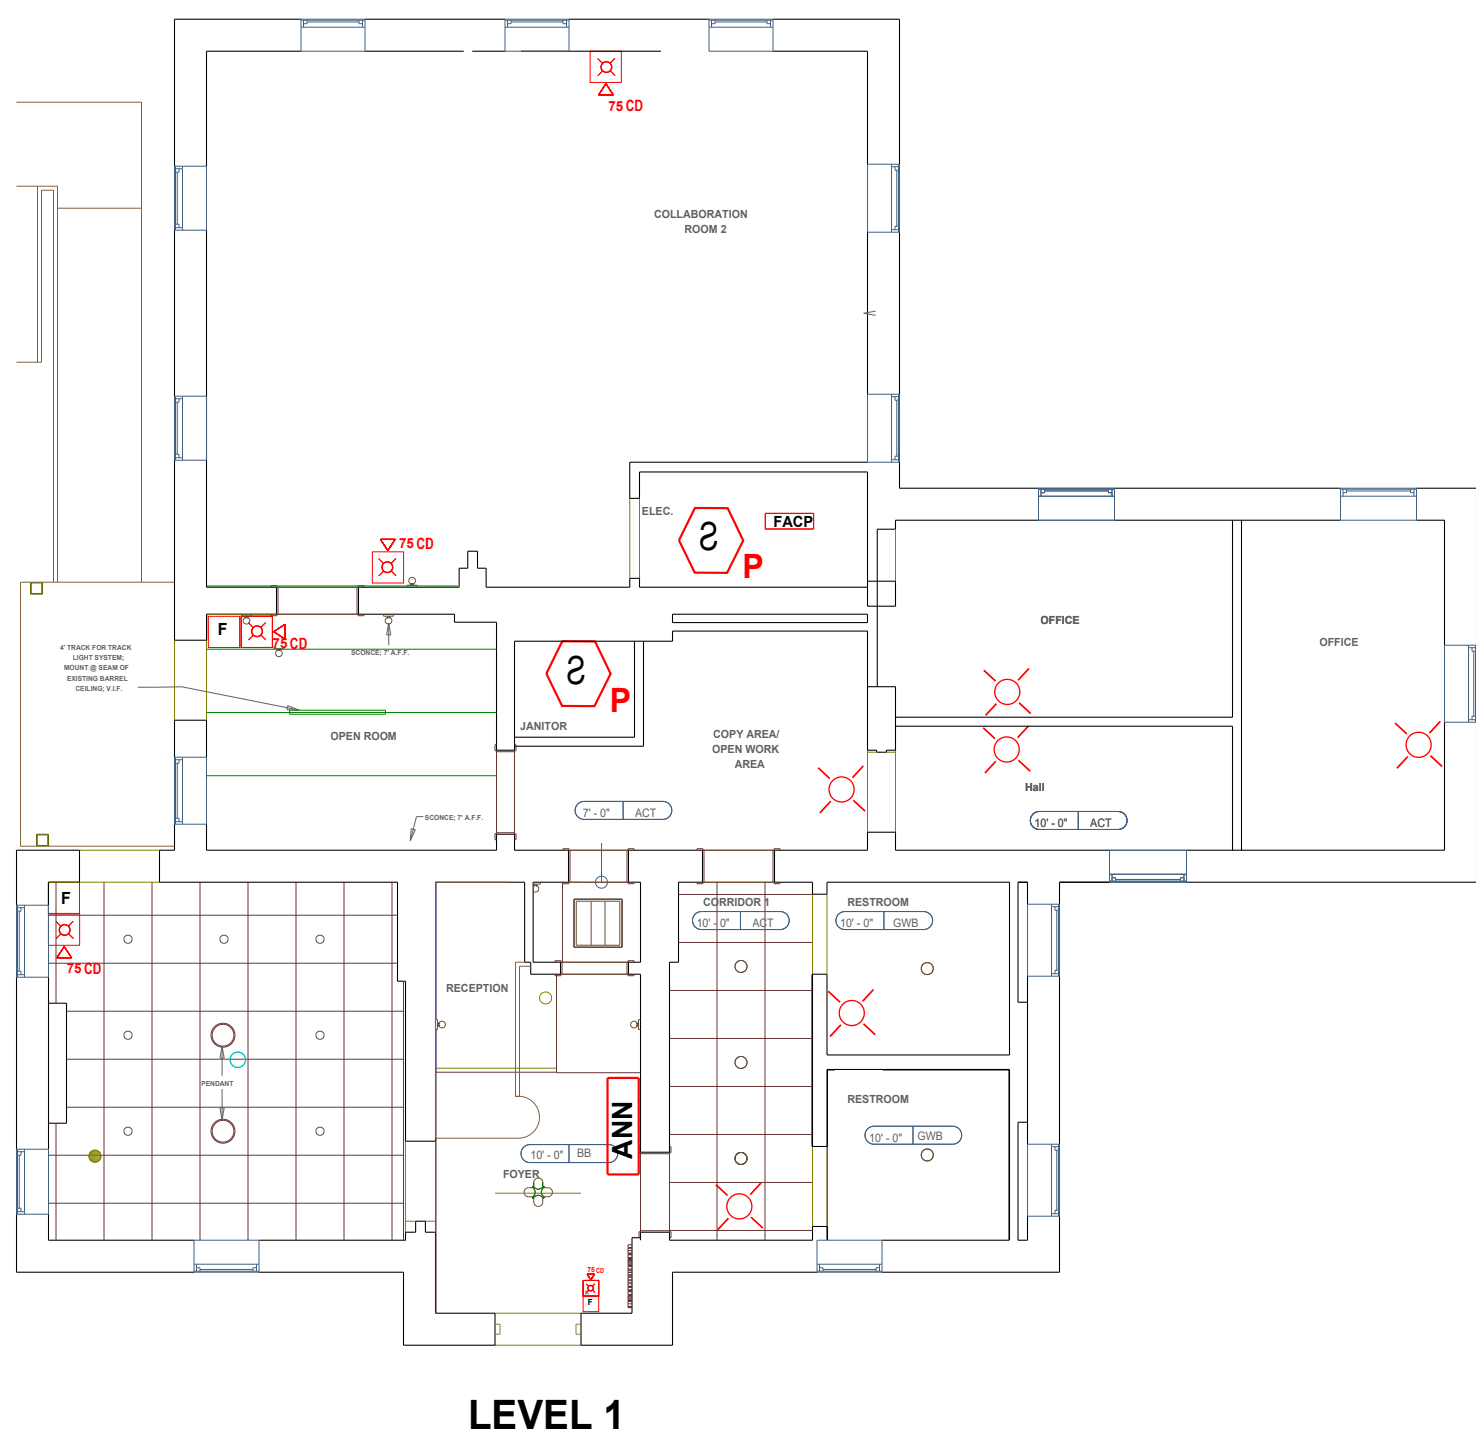

Plan Fire Alarm System

AS-BUILT

HISTORIC
PRESERVATION