



10641 Highway 36
Covington, GA
30014

www.sunbeltbuilders.com


t 770.786.3031
f 770.786.3046

HISTORIC JAIL RENOVATIONS

Sunbelt Builders, Inc.
10641 Hwy. 36
Covington, GA 30014
ph: 770-786-3031
Bo Childers, Project Manager
bchilders@sunbeltbuilders.com

Architectural As-built

ALPHA BLDG SET 10-06-2025

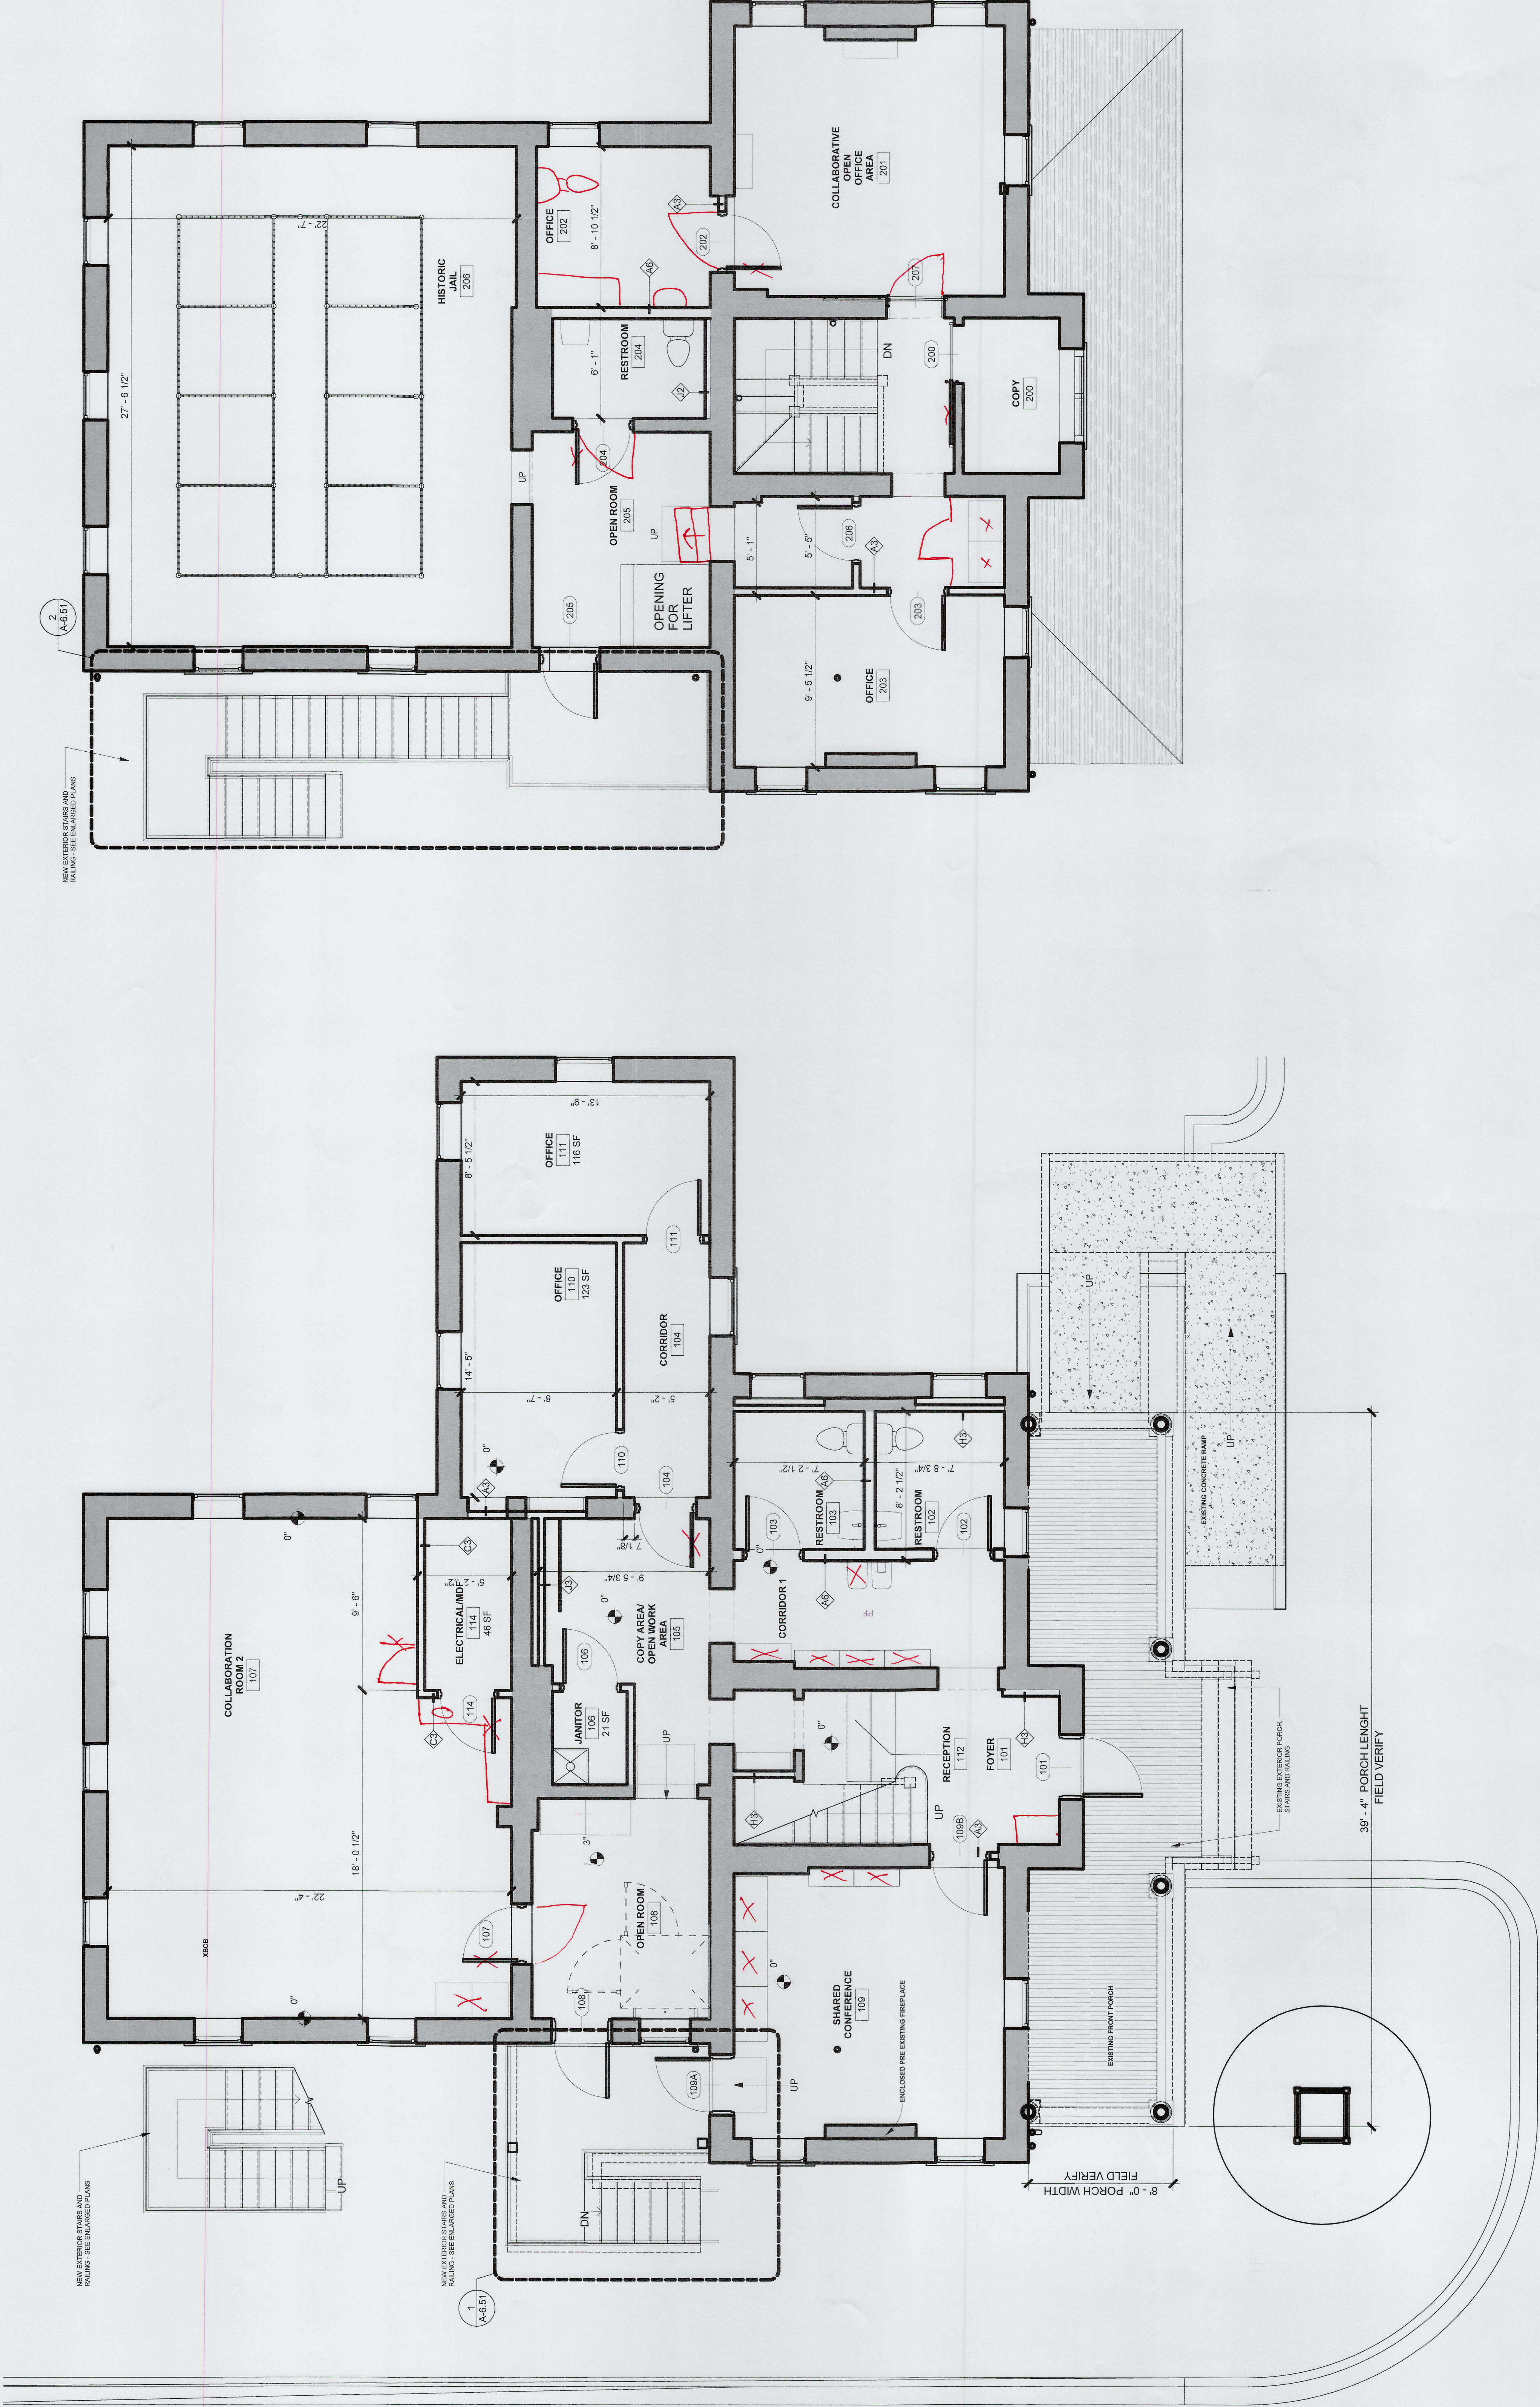

1 REFERENCE PLAN - LEVEL 1
SCALE: 1/4" = 1'-0"

2

REFERENCE PLAN - LEVEL 2
 SCALE: 1/4" = 1'-0"

PRINT RECORD		
No.	DATE	DESCRIPTION
1	09-23-2024	ISSUED FOR PRICING

Drawn By BC	Checked By JDG
Date 05-16-2025	Job No. 24004

Sheet Title
REFERENCE PLANS

Sheet No.

A-1.01R

NOT RELEASED FOR CONSTRUCTION

