10641 Highway 36
Covington, GA
30014

www.sunbeltbuilders.com

t 770.786.3031
f 770.786.3046

JACKSON COUNTY
AIRPORT TERMINAL BUILDING

Sunbelt Builders, Inc.
10641 Hwy. 36
Covington, GA 30014
ph: 770-786-3031
Mike McCrorey
mmccrorey@sunbeltbuilders.com

Water Line Extension As-built

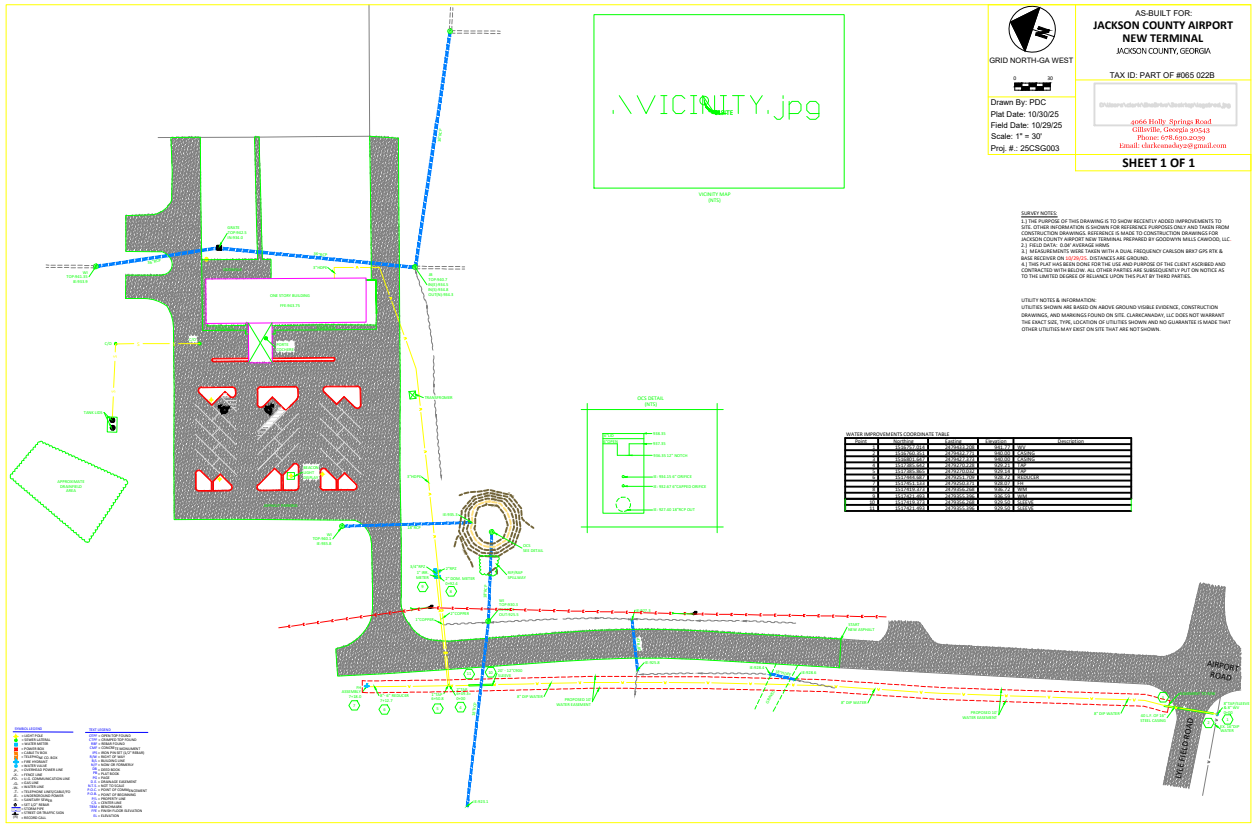
ONE STORY BUILDING
FFE:843.75
APPROXIMATE GRADING LIMIT
TANK LIGHT
CO
VICINITY MAP
(NTS)
OCS DETAIL
(NTS)
AIRPORT ROAD
SUGARLOAF ROAD
PROPOSED 10' WATER EASEMENT
8" DIP WATER
4" DIP WATER
LIGHT PAIR ASPHALT
STEEL CHAINS
BELLSOUTH
TELEPHONE
POWER
SIGN
SIGN
SIGN