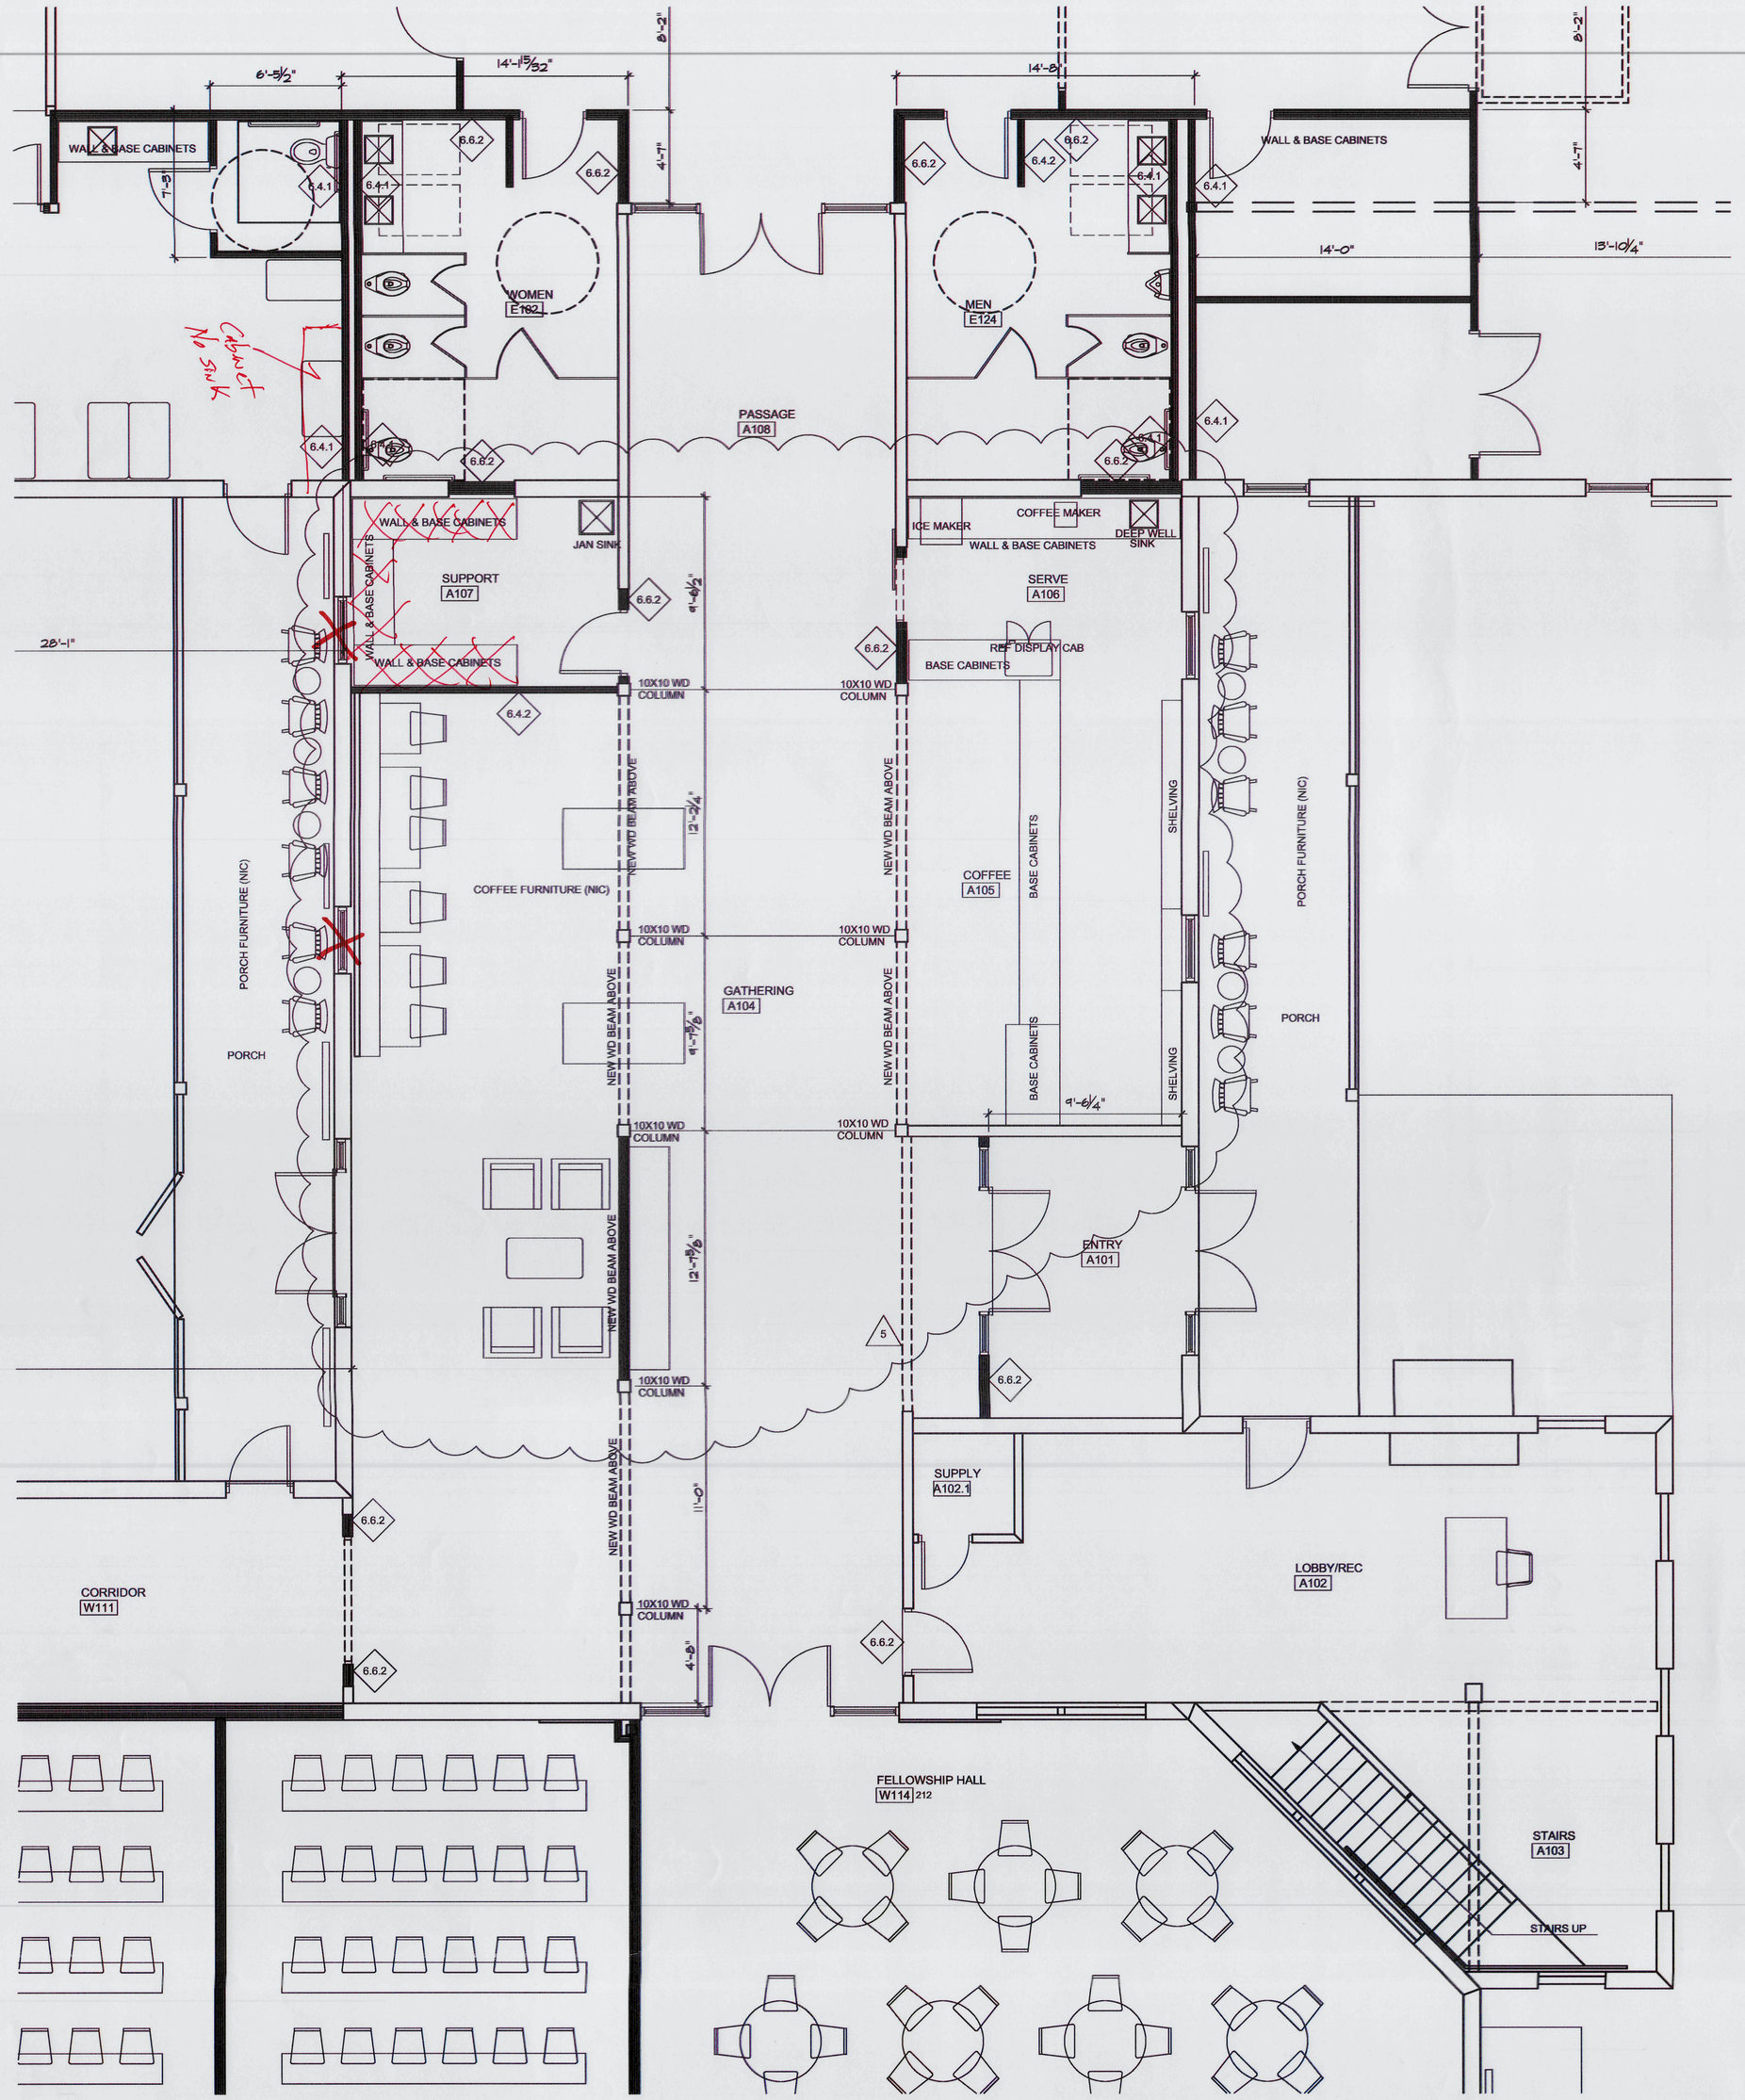

NOTE: SEE SHEET A1.0.1 FOR PARTITION TYPES 6.6.7

D1 A1.1.3 PROJ. NORTH

FIRST FLOOR PLAN: GATHERING-PHASE I

SCALE: 1/8" = 1'-0"

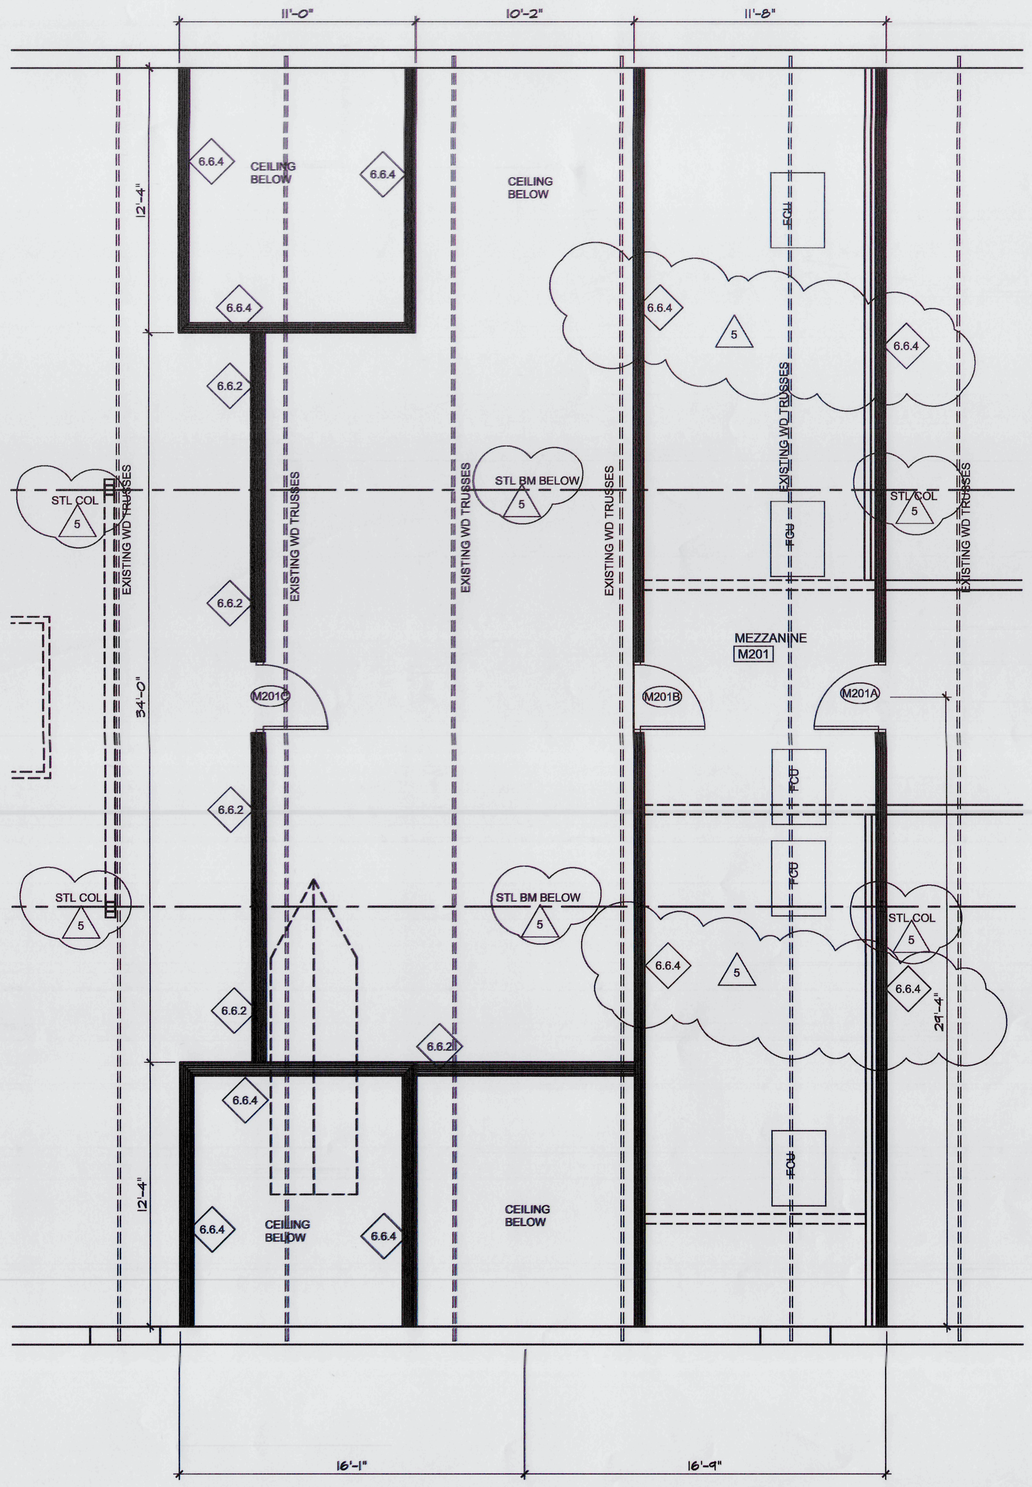

NOTE: SEE SHEET A1.0.1 FOR PARTITION TYPES 6.6.7

D4 A1.1.3 PROJ. NORTH

FLOOR PLAN: MECH MEZZANINE-PHASE I

SCALE: 1/8" = 1'-0"

SCALE IN FEET

GM Architect
102 Sammy Court
WARNER ROBINS, GEORGIA 31088
gimarch@outlook.com
(478)-365-8976

ARCHITECT

STATE OF GEORGIA · GARY L. MCNUTT · CERTIFICATE NO. 20041 · REGISTERED ARCHITECT

STAMP INVALID UNLESS SIGNED

CONSULTANT

STAMP INVALID UNLESS SIGNED

SUNBELT BUILDERS
10641 HIGHWAY 36
COVINGTON, GA 30014
770.786.3031

FIRST FLOOR PLAN

Retrofit & Renovations for Madison Methodist Church

1091 Confederate Highway
Madison, Georgia 30650

JOB NO.:	02405
DRAWN BY:	GM
CHECKED BY:	GM
DESCRIPTION:	SCH-REVIEW-P1
DATE:	08.04.24
DESCRIPTION:	DD-REVIEW
DATE:	00.00.24
DESCRIPTION:	CD-REVIEW
DATE:	01.02.25
DESCRIPTION:	BID-CONSTRUCTION
DATE:	01.21.25

REVISIONS:

1	03.24.25	8	
2	04.21.25	9	
3	08.11.25	10	
4	08.20.25	11	
5	09.03.25	12	
6	09.03.25	13	
7		14	

THESE DRAWINGS ARE THE PROPERTY OF GMarchitect AND ARE NOT TO BE REPRODUCED OR REUSED WITHOUT PERMISSION AND CREDIT.
COPYRIGHT: © 2025

SHEET

A1.1.3

OF